

THE INFORMATION CONTAINED IN THIS DRAWING IS THE SOLE PROPERTY OF APICAL INDUSTRIES DBA DART AEROSPACE. ANY REPRODUCTION IN PART OR WHOLE WITHOUT THE WRITTEN PERMISSION OF APICAL INDUSTRIES DBA DART AEROSPACE IS PROHIBITED.

REVISIONS			
REV.	DESCRIPTION	DATE	APPROVED
	LAST PROTOTYPE REVISION: PR4		
N/C	INITIAL RELEASE	01/13/09	P. BRAVO
A	INCORPORATED ECNS 02938, 03000, 03044, 03066	02/16/11	P. BRAVO
B	INCORPORATED ECN 05325	03/09/16	P. BRAVO
C	INCORPORATED ECN 05550, 05465	11/01/16	P. BRAVO
D	INCORPORATED ECN 05882	11/27/17	P. BRAVO
E	INCORPORATED ECN 05907	02/06/20	P. BRAVO
F	INCORPORATED ECN 06485	06/02/20	FOR P. BRAVO

A/R	A/R	A/R	A/R	A/R	A/R	A/R	A/R	A/R	A/R	A/R	A/R	A/R	A/R	A/R	A/R	A/R	A/R	A/R	A/R	A/R	A/R	A/R	A/R	A/R	A/R	A/R	A/R	4	601.2045	RTV	LOCTITE 598	
A/R	A/R	A/R	A/R	A/R	A/R	A/R	A/R	A/R	A/R	A/R	A/R	A/R	A/R	A/R	A/R	A/R	A/R	A/R	A/R	A/R	A/R	A/R	A/R	A/R	A/R	A/R	A/R	3	600.1012	SEALANT	PR-1425 CLASS B	
A/R	A/R	A/R	A/R	A/R	A/R	A/R	A/R	A/R	A/R	A/R	A/R	A/R	A/R	A/R	A/R	A/R	A/R	A/R	A/R	A/R	A/R	A/R	A/R	A/R	A/R	A/R	2	600.0991	MAGNOBOND 6398 PART B			
A/R	A/R	A/R	A/R	A/R	A/R	A/R	A/R	A/R	A/R	A/R	A/R	A/R	A/R	A/R	A/R	A/R	A/R	A/R	A/R	A/R	A/R	A/R	A/R	A/R	A/R	A/R	1	600.0990	MAGNOBOND 6398 PART A			
X									1								1											647.7361	T3H/P3H UPR CTR REMOVABLE PROVISIONS			
	X																1				1							647.7352	T2/P2/T3/P3/T3H/P3H SKID DEFLECTOR ASSEMBLY			
		X																							1			647.7351	T1/P1 SKID DEFLECTOR ASSEMBLY			
			X														1					1			1			647.7341	UNIVERSAL WIPER DEFLECTOR ASSEMBLY			
				X	1												1		1		1							647.7335	T2/P2/T3/P3/T3H/P3H LWR CTR REMOVABLE PROVISIONS			
					X																							647.7334	T2/P2/T3/P3/T3H/P3H LOWER CUTTER ASSEMBLY			
						X		1																				647.7333	T1/P1 LWR CTR REMOVABLE PROVISIONS			
					1		X	1										1			1			1				647.7332	UNIVERSAL LWR CTR FIXED PROVISIONS			
								X																				647.7331	T1/P1 LOWER CUTTER ASSEMBLY			
									X																			647.7329	T3H/P3H UPPER CUTTER ASSEMBLY			
										X	1										1							647.7328	T3/P3 UPR CTR REMOVABLE PROVISIONS			
											X																	647.7327	T3/P3 UPPER CUTTER ASSEMBLY			
												X		1							1							647.7326	T2/P2 UPR CTR REMOVABLE PROVISIONS			
								1		1		X	1									1						647.7325	T2/P2/T3/P3 UPR CTR FIXED PROVISIONS			
												X																647.7324	T2/P2 UPPER CUTTER ASSEMBLY			
													X	1											1			647.7323	T1/P1 UPR CTR REMOVABLE PROVISIONS			
													X	1												1		647.7322	T1/P1 UPR CTR FIXED PROVISIONS			
														X														647.7321	T1/P1 UPPER CUTTER ASSEMBLY			
															X	1												647.7310	T3H/P3H REMOVABLE PROVISIONS			
																X												647.7309	T3H/P3H CABLE CUTTER KIT ASSEMBLY			
																	X	1										647.7308	T3/P3 REMOVABLE PROVISIONS			
																		X										647.7307	T3/P3 CABLE CUTTER KIT ASSEMBLY			
																				X		1						647.7306	T2/P2 REMOVABLE PROVISIONS			
																			1		X	1						647.7305	T2/P2/T3/P3 FIXED PROVISION			
																						X						647.7304	T2/P2 CABLE CUTTER KIT ASSEMBLY			
																							X		1			647.7303	T1/P1 REMOVABLE PROVISIONS			
																								X	1			647.7302	T1/P1 FIXED PROVISIONS			
																									X			647.7301	T1/P1 CABLE CUTTER KIT ASSEMBLY			
7361	7352	7351	7341	7335	7334	7333	7332	7331	7329	7328	7327	7326	7325	7324	7323	7322	7321	7310	7309	7308	7307	7306	7305	7304	7303	7302	7301	FIND #	PART #	DESCRIPTION	MAT'L	SPEC.

QTY		PARTS LIST			
NEXT ASSY (\$)	ORIGINAL DATE (MO-DA-YR)		11/24/09		
	DRAWN BY		CHECKER		
	A. QUAN		D. BARKER		
	DRAWING APPROVAL				
	P. BRAVO				
	01/13/10				
	CONTRACT No.				
	UNLESS OTHERWISE SPECIFIED				
	DIMENSIONS ARE IN INCHES				
	TOLERANCES ARE:				
	2 PLACE DECIMALS ±.01				
	3 PLACE DECIMALS ±.005				
	ANGLES ± .5°				
SIZE		CAGE CODE	DWG. NO.		REV.
B		07MZ6	647.7300		F
SCALE NONE				SHEET 1 OF 25	

UNDER REVIEW
ECR: #16 20.08.05 (JB)

D

UNDER REVIEW
ECR: #16 20.08.05 (JB)

D

UNDER REVIEW
ECR: #16 20.08.05 (JB)

NOTES UNLESS OTHERWISE SPECIFIED:


- A

B



C

D

UNDER REVIEW
ECR: #16 20.08.05 (JB)

ORIGINAL DATE (MO-DA-YR) 11/24/09		 DART AEROSPACE APICAL INDUSTRIES, INC. dba DART AEROSPACE		3030 ENTERPRISE CT., SUITE A VISTA, CA. 92081 (760)-724-5300	
DRAWN BY A. QUAN	CHECKER D. BARKER				
DRAWING APPROVAL P. BRAVO 01/13/10					
CONTRACT NO.		EC135 CABLE CUTTERS KIT			
UNLESS OTHERWISE SPECIFIED DIMENSIONS ARE IN INCHES TOLERANCES ARE: 2 PLACE DECIMALS ±.01 3 PLACE DECIMALS ±.005 ANGLE ±.5°		SIZE B	CAGE CODE 07MZ6	DWG. NO. 647.7300	REV. F
SCALE NONE			SHEET 4 OF 25		

THE INFORMATION CONTAINED IN THIS DRAWING IS THE SOLE PROPERTY OF APICAL INDUSTRIES DBA DART AEROSPACE. ANY REPRODUCTION IN PART OR WHOLE WITHOUT THE WRITTEN PERMISSION OF APICAL INDUSTRIES DBA DART AEROSPACE IS PROHIBITED.

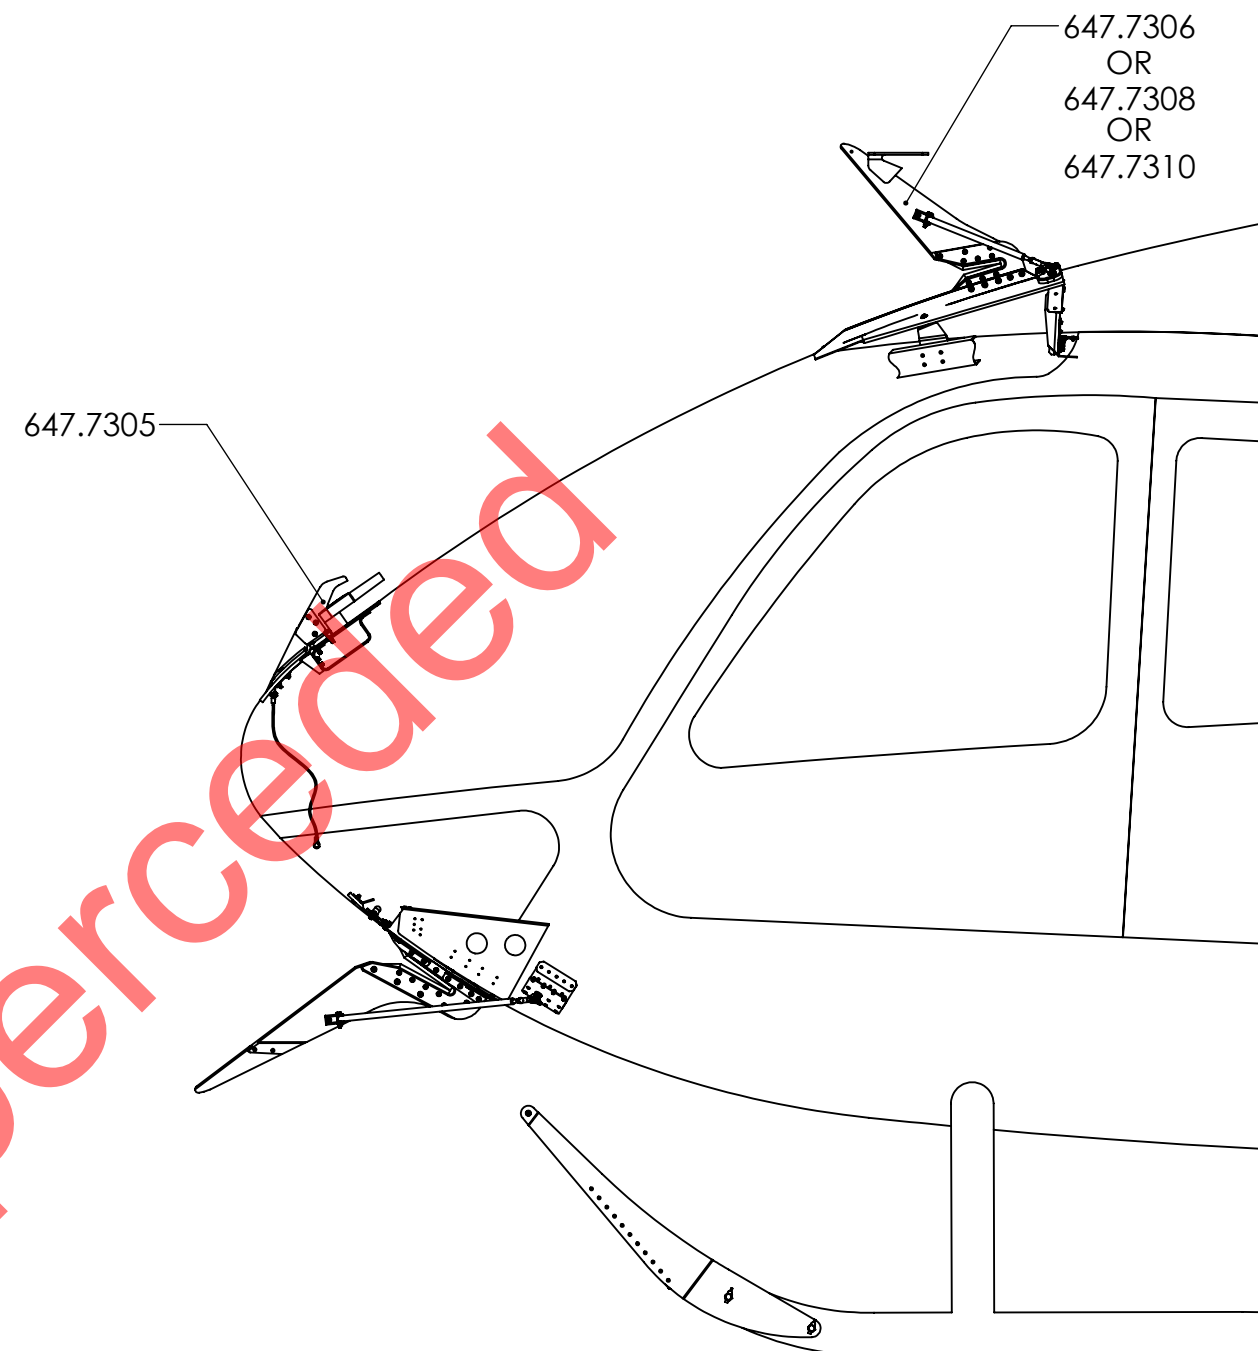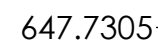


647.7304 T2/P2 CABLE CUTTERS KIT (SHOWN)
647.7307 T3/P3 CABLE CUTTERS KIT (TYP)
647.7309 T3H/P3H CABLE CUTTERS KIT (TYP)

 \triangle

ORIGINAL DATE (MO-DA-YR) 11/24/09	 3030 ENTERPRISE CT. SUITE A VISTA, CA. 92081 (760)-724-5300		
DRAWN BY A. QUAN	CHECKED D. BARKER		
DRAWING APPROVAL P. BRAVO 01/13/10		APICAL INDUSTRIES, INC. dba DART AEROSPACE	
CONTRACT NO.		EC135 CABLE CUTTERS KIT	
UNLESS OTHERWISE SPECIFIED DIMENSIONS ARE IN INCHES TOLERANCES ARE: 2 PLACE DECIMALS ±.001 3 PLACE DECIMALS ±.005 ANGLES ±.5°		SIZE CAGE CODE DWG. NO. B 07MZ6 647.7300	REV F
		SCALE NONE	SHEET 5 OF 25

~~UNDER REVIEW~~
ECR: #16 20.08.05 (JB)




ORIGINAL DATE (MO-DA-YR)		11/24/09		 <div>3030 ENTERPRISE CT., SUITE A VISTA, CA. 92081 (760)-724-5300</div> <div>APICAL INDUSTRIES, INC. dba DART AEROSPACE</div>
DRAWN BY A. QUAN		CHECKER D. BARKER		
DRAWING APPROVAL P. BRAVO 01/13/10				
CONTRACT NO.				EC135 CABLE CUTTERS KIT
UNLESS OTHERWISE SPECIFIED DIMENSIONS ARE IN INCHES TOLERANCES ARE: 2 PLACE DECIMALS ±.001 3 PLACE DECIMALS ±.005 ANGLES ±.5°				
SIZE				
CAGE CODE B	DWG. NO. 647.7300		REV. F	
SCALE NONE			SHEET 6 OF 25	

UNDER REVIEW
ECR: #16 20.08.05 (JB)

THE INFORMATION CONTAINED IN THIS DRAWING IS THE SOLE PROPERTY OF APICAL INDUSTRIES DBA DART AEROSPACE. ANY REPRODUCTION IN PART OR WHOLE WITHOUT THE WRITTEN PERMISSION OF APICAL INDUSTRIES DBA DART AEROSPACE IS PROHIBITED.

A
B
C
D

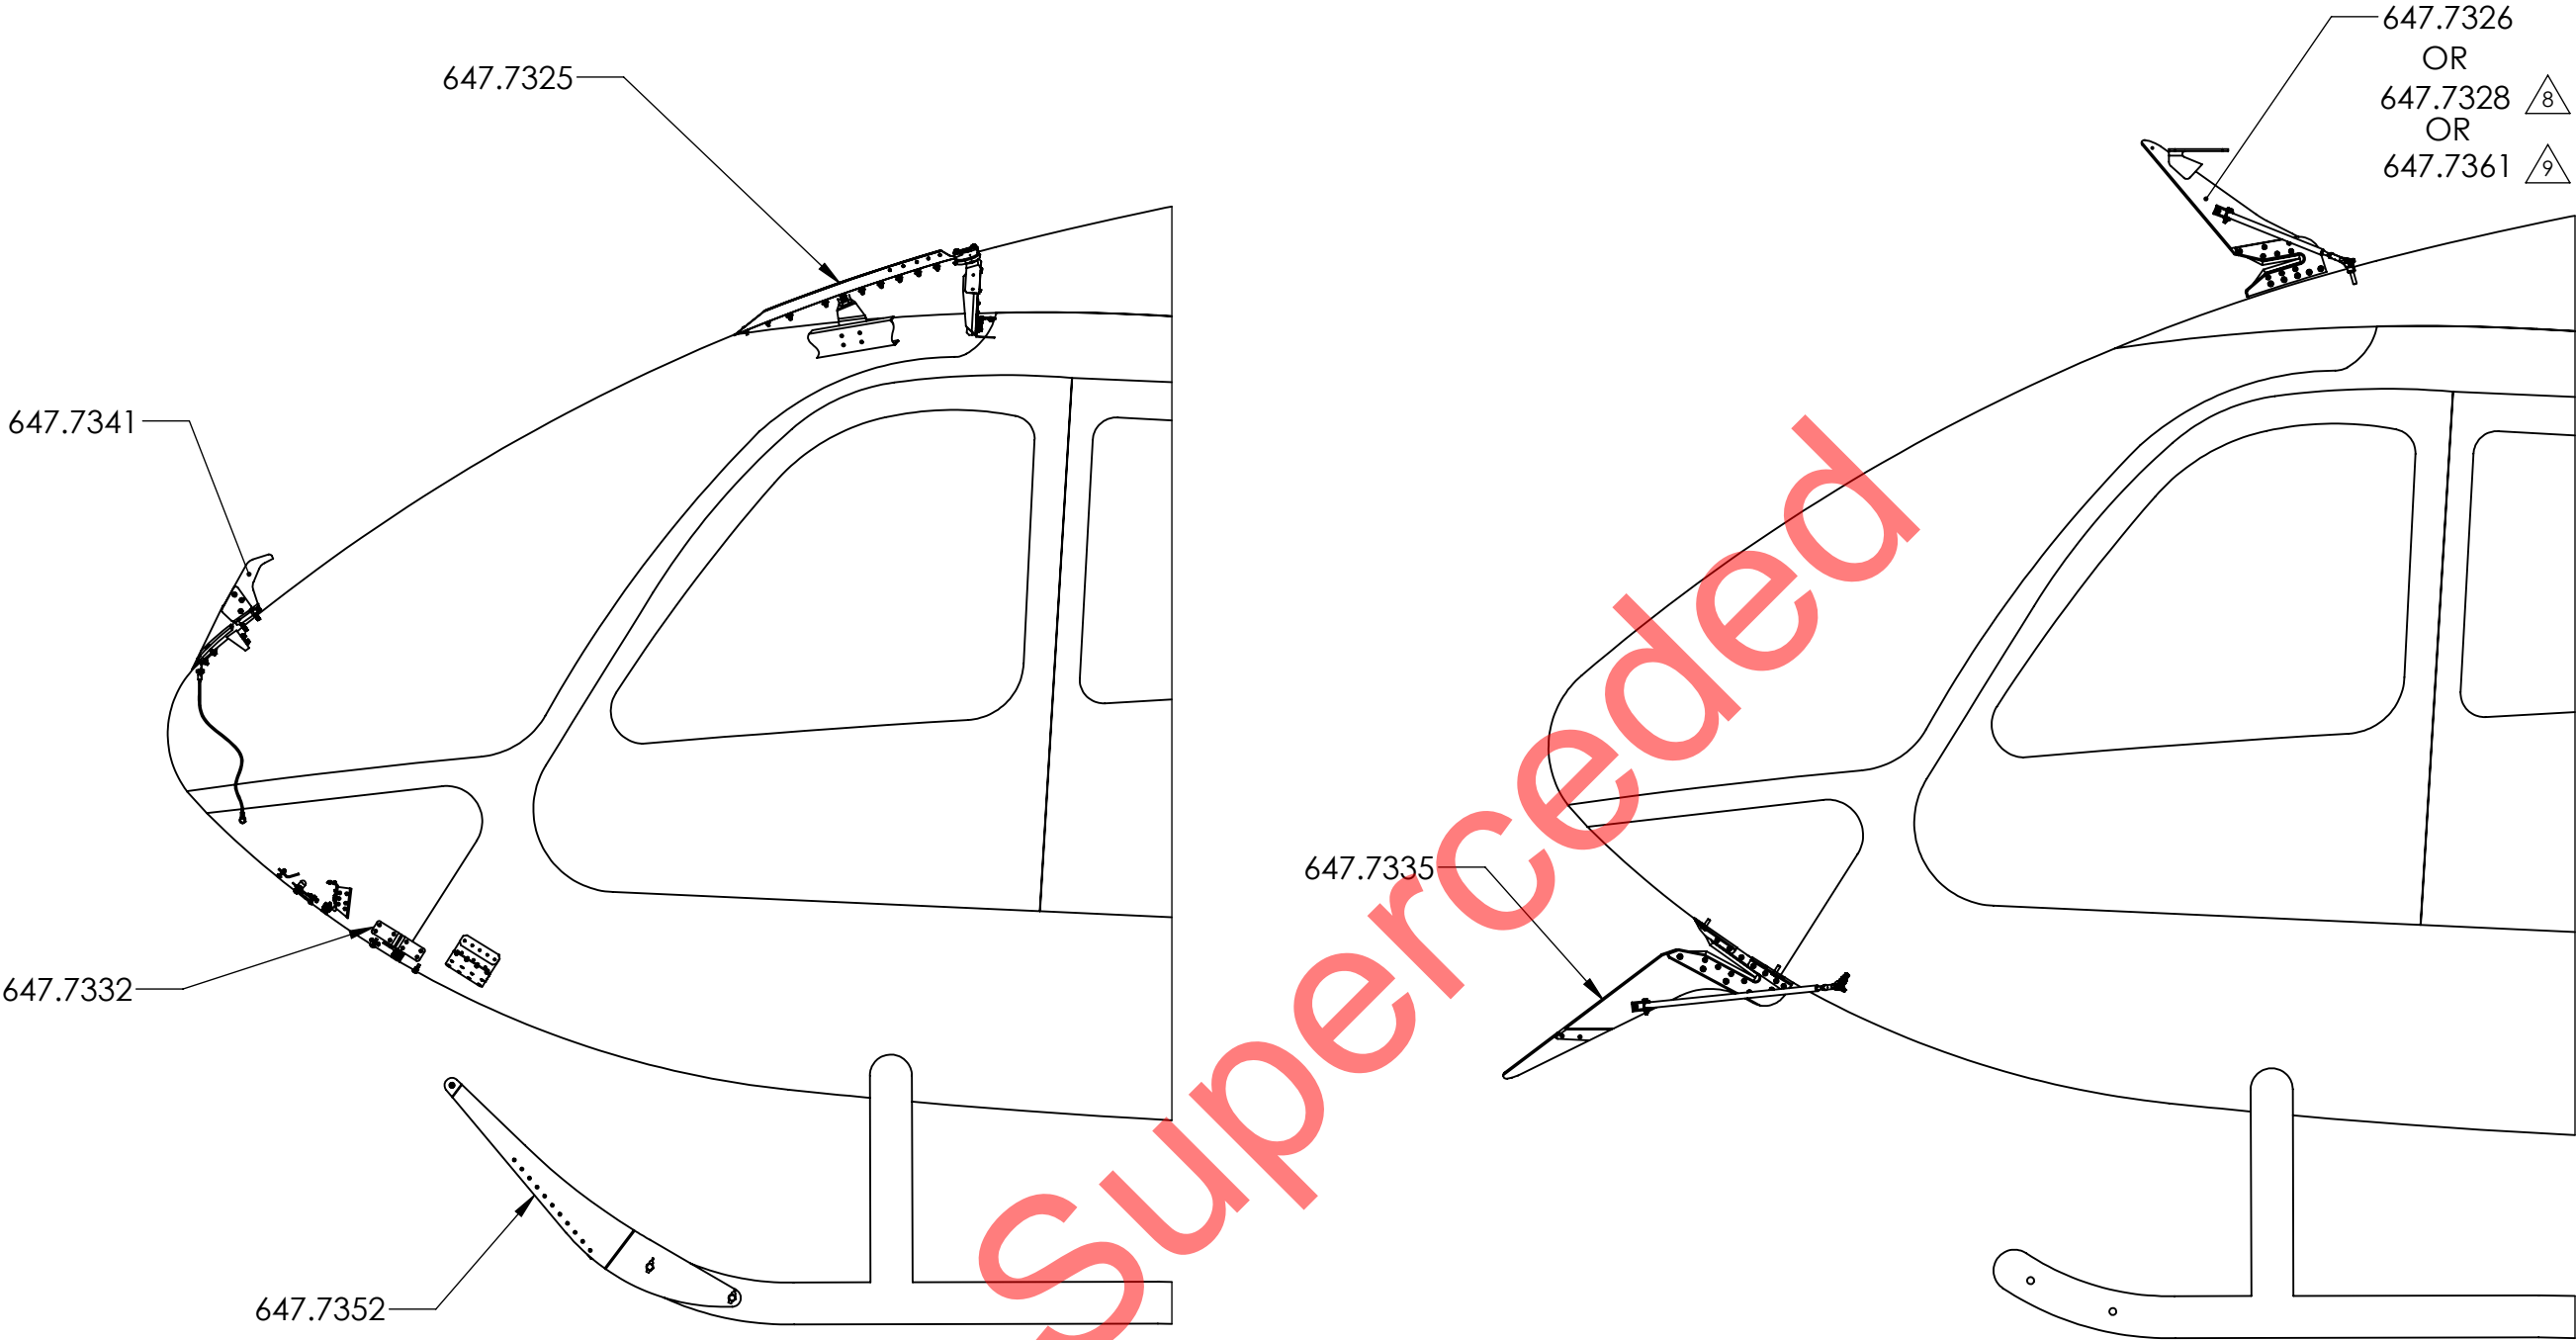

647.7305 T2/P2/T3/P3/T3H/P3H FIXED PROVISIONS

647.7306 T2/P2 REMOVABLE PROVISIONS (SHOWN)
647.7308 T3/P3 REMOVABLE PROVISIONS (TYP)
647.7310 T3H/P3H REMOVABLE PROVISIONS (TYP)

UNDER REVIEW
ECR: #16 20.08.05 (JB)

ORIGINAL DATE (MO-DA-YR) 11/24/09		DART 3030 ENTERPRISE CT., SUITE A VISTA, CA. 92081 (760)-724-5300	
DRAWN BY A. QUAN	CHECKER D. BARKER		
DRAWING APPROVAL P. BRAVO 01/13/10		APICAL INDUSTRIES, INC. dba DART AEROSPACE	
CONTRACT No.		EC135 CABLE CUTTERS KIT	
UNLESS OTHERWISE SPECIFIED DIMENSIONS ARE IN INCHES TOLERANCES ARE: 2 PLACE DECIMALS ±.01 3 PLACE DECIMALS ±.005 ANGLES ±.5°		SIZE B 07MZ6	REV. F
		DWG. NO. 647.7300	SHEET 7 OF 25
		SCALE NONE	


THE INFORMATION CONTAINED IN THIS DRAWING IS THE SOLE PROPERTY OF APICAL INDUSTRIES DBA DART AEROSPACE. ANY REPRODUCTION IN PART OR WHOLE WITHOUT THE WRITTEN PERMISSION OF APICAL INDUSTRIES DBA DART AEROSPACE IS PROHIBITED.

A

B


C

D

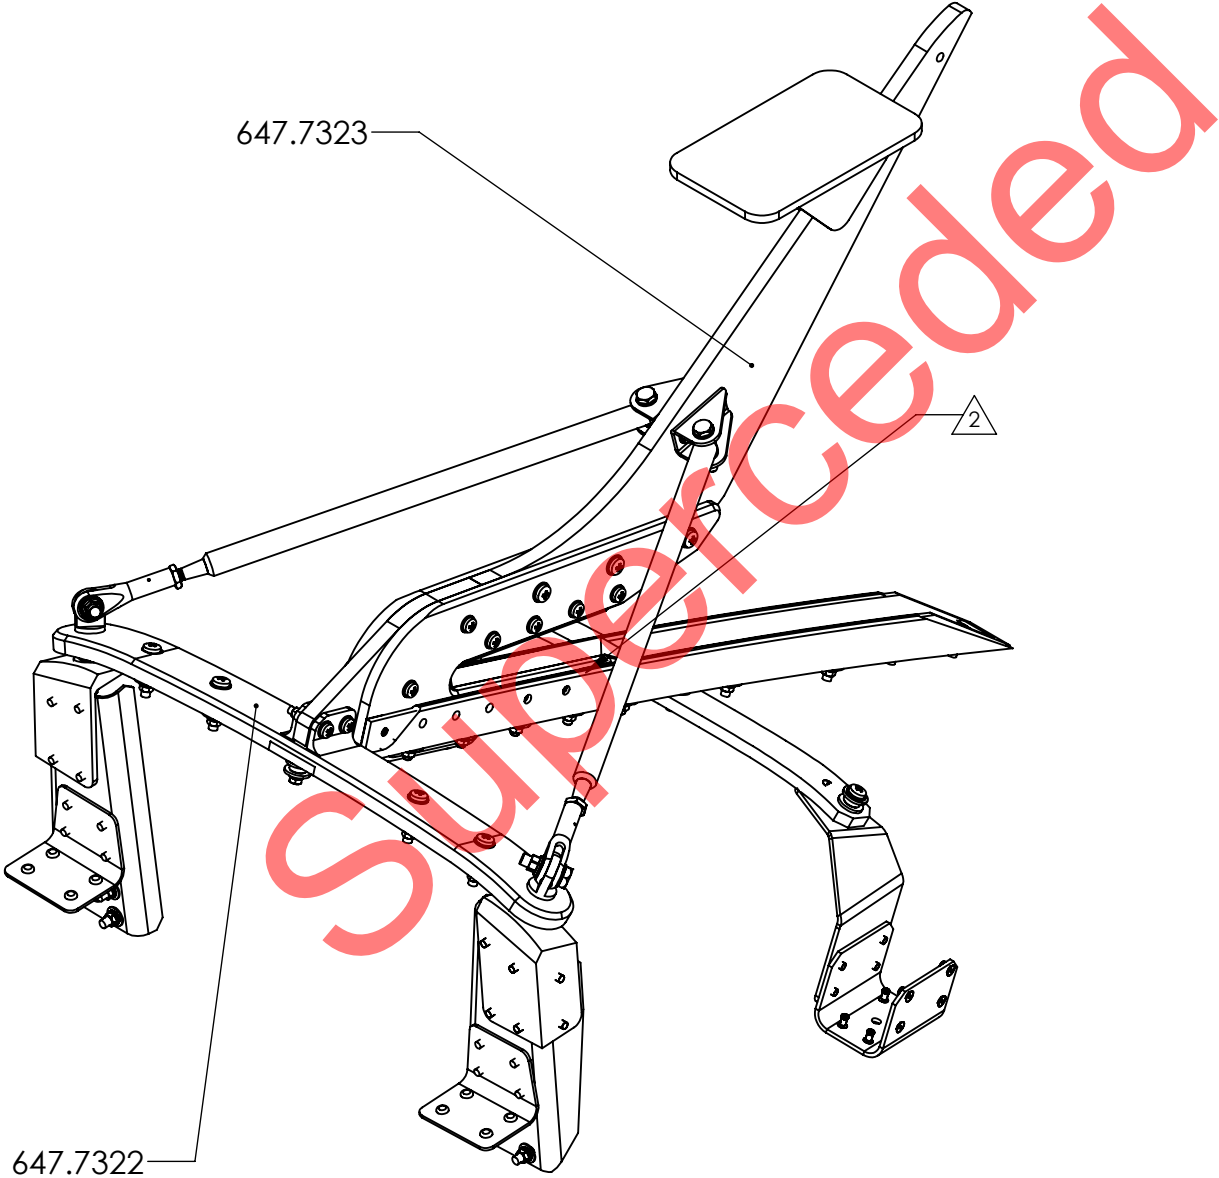

647.7321 T1/P1 UPPER CUTTER ASSEMBLY

UNDER REVIEW
ECR: #16 20.08.05 (JB)

ORIGINAL DATE (MO-DA-YR) 11/24/09		 DART AEROSPACE APICAL INDUSTRIES, INC. dba DART AEROSPACE		3030 ENTERPRISE CT., SUITE A VISTA, CA. 92081 (760)-724-5300	
DRAWN BY A. QUAN	CHECKER D. BARKER				
DRAWING APPROVAL P. BRAVO 01/13/10		EC135 CABLE CUTTERS KIT			
CONTRACT No.		SIZE	CAGE CODE	DWG. NO.	REV.
UNLESS OTHERWISE SPECIFIED DIMENSIONS ARE IN INCHES TOLERANCES ARE: 2 PLACE DECIMALS ±.01 3 PLACE DECIMALS ±.005 ANGLES ± .5°		B	07MZ6	647.7300	F
		SCALE NONE		SHEET	8 OF 25

A

B


Q

D




~~UNDER REVIEW~~
ECR: #16 20.08.05 (JB)

PRINTED COPY OF THIS DOCUMENT IS FOR REFERENCE ONLY AND IS UNCONTROLLED

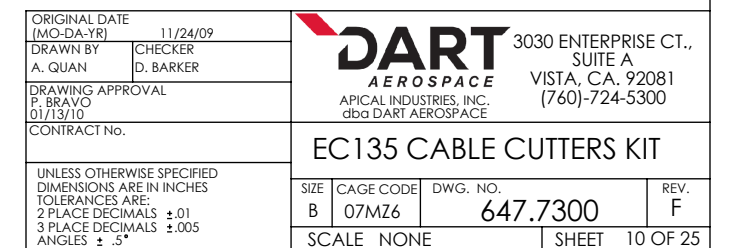


UNDER REVIEW
ECR: #16 20.08.05 (JB)

THE INFORMATION CONTAINED IN THIS DRAWING IS THE SOLE PROPERTY OF APICAL INDUSTRIES DBA DART AEROSPACE. ANY REPRODUCTION IN PART OR WHOLE WITHOUT THE WRITTEN PERMISSION OF APICAL INDUSTRIES DBA DART AEROSPACE IS PROHIBITED.

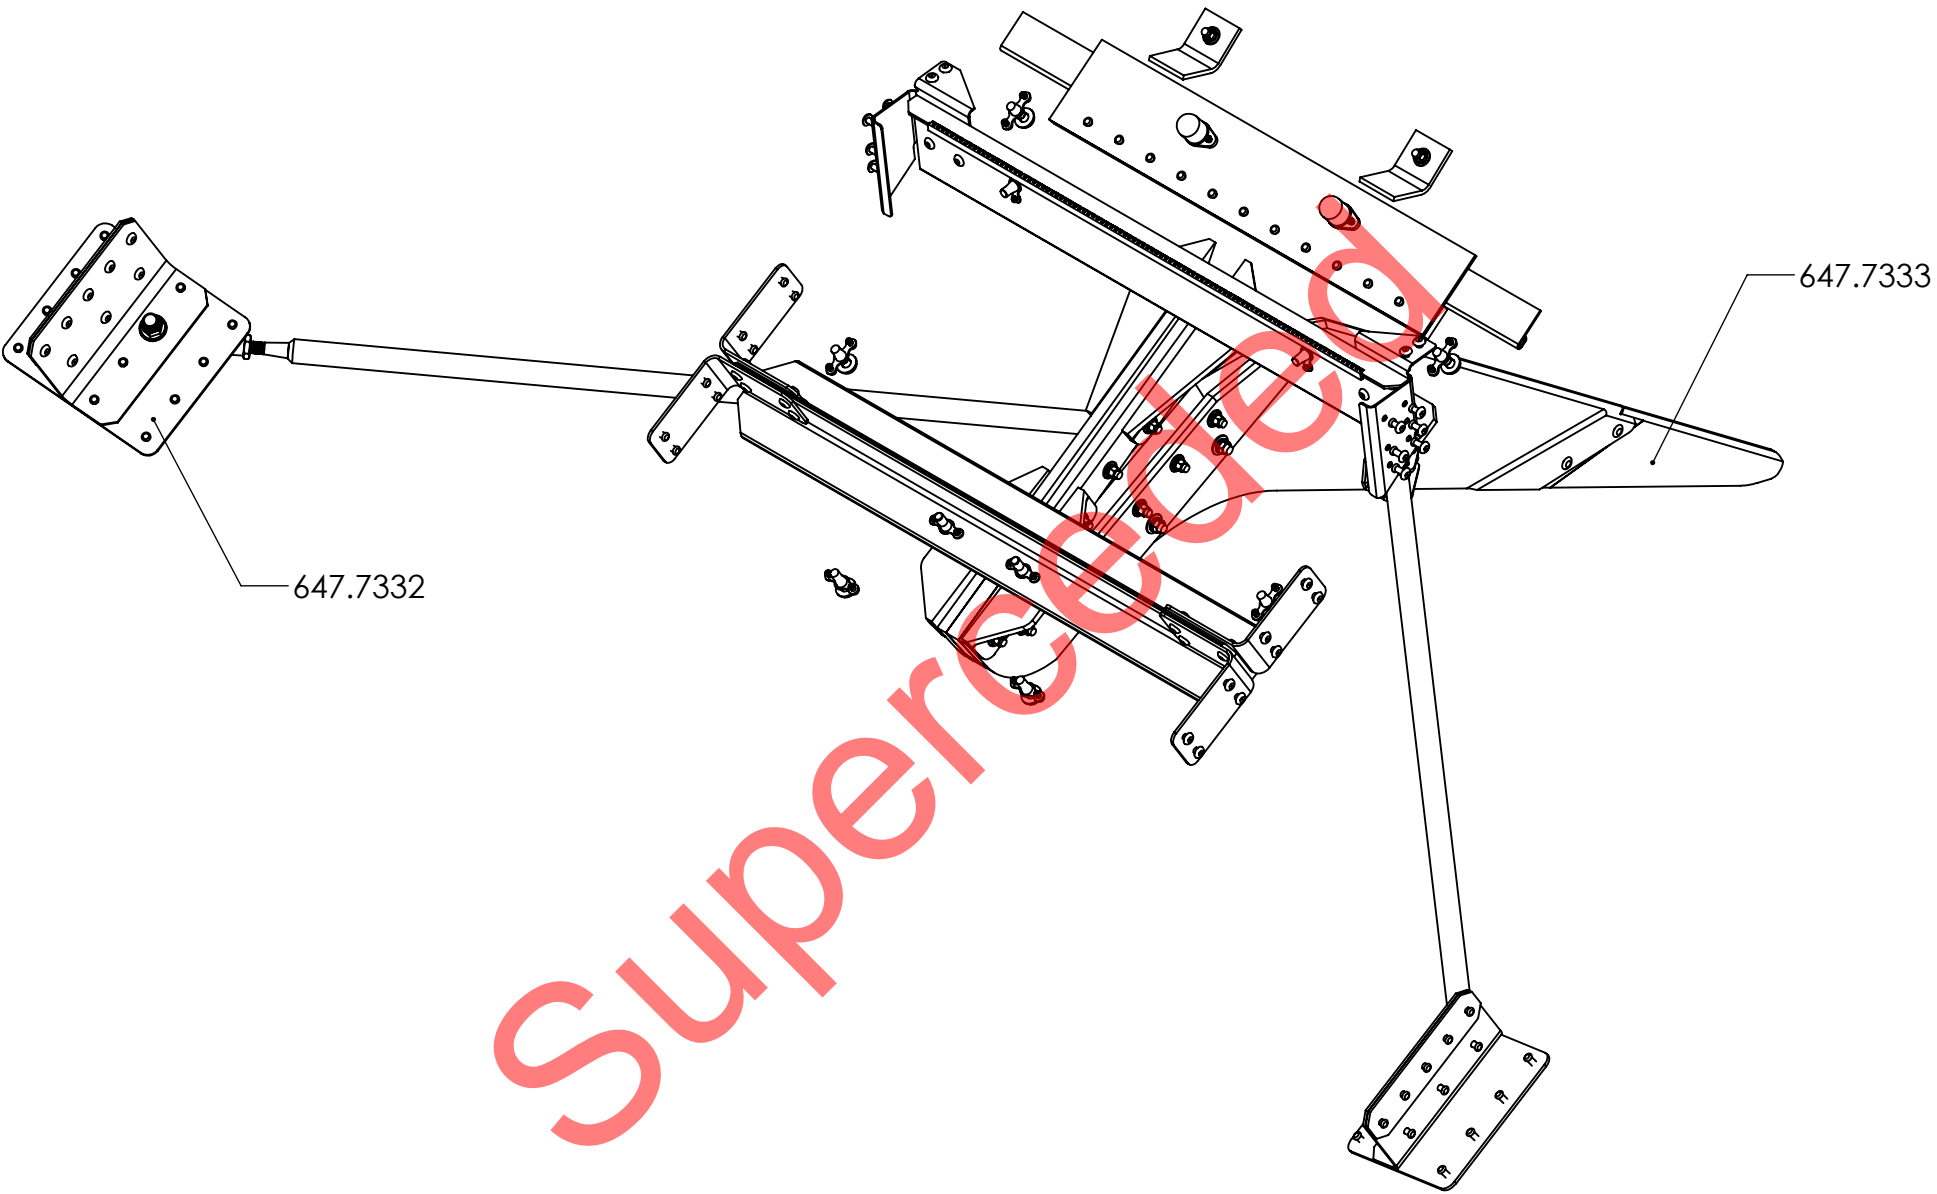


647.7331 T1/P1 LOWER CUTTER ASSEMBLY

ORIGINAL DATE (MO-DA-YR) 11/24/09		 3030 ENTERPRISE CT., SUITE A VISTA, CA. 92081 (760)-724-5300	
DRAWN BY A. QUAN	CHECKER D. BARKER		
DRAWING APPROVAL P. BRAVO 01/13/10		APICAL INDUSTRIES, INC. dba DART AEROSPACE	
CONTRACT No.		EC135 CABLE CUTTERS KIT	
UNLESS OTHERWISE SPECIFIED DIMENSIONS ARE IN INCHES TOLERANCES ARE: 2 PLACE DECIMALS ±.01 3 PLACE DECIMALS ±.005 ANGLES ± .5°		SIZE B	REV. F
		CAGE CODE 07MZ6	DWG. NO. 647.7300
		SCALE NONE	SHEET 11 OF 25

UNDER REVIEW
ECR: #16 20.08.05 (JB)

THE INFORMATION CONTAINED IN THIS DRAWING IS THE SOLE PROPERTY OF APICAL INDUSTRIES DBA DART AEROSPACE. ANY REPRODUCTION IN PART OR WHOLE WITHOUT THE WRITTEN PERMISSION OF APICAL INDUSTRIES DBA DART AEROSPACE IS PROHIBITED.

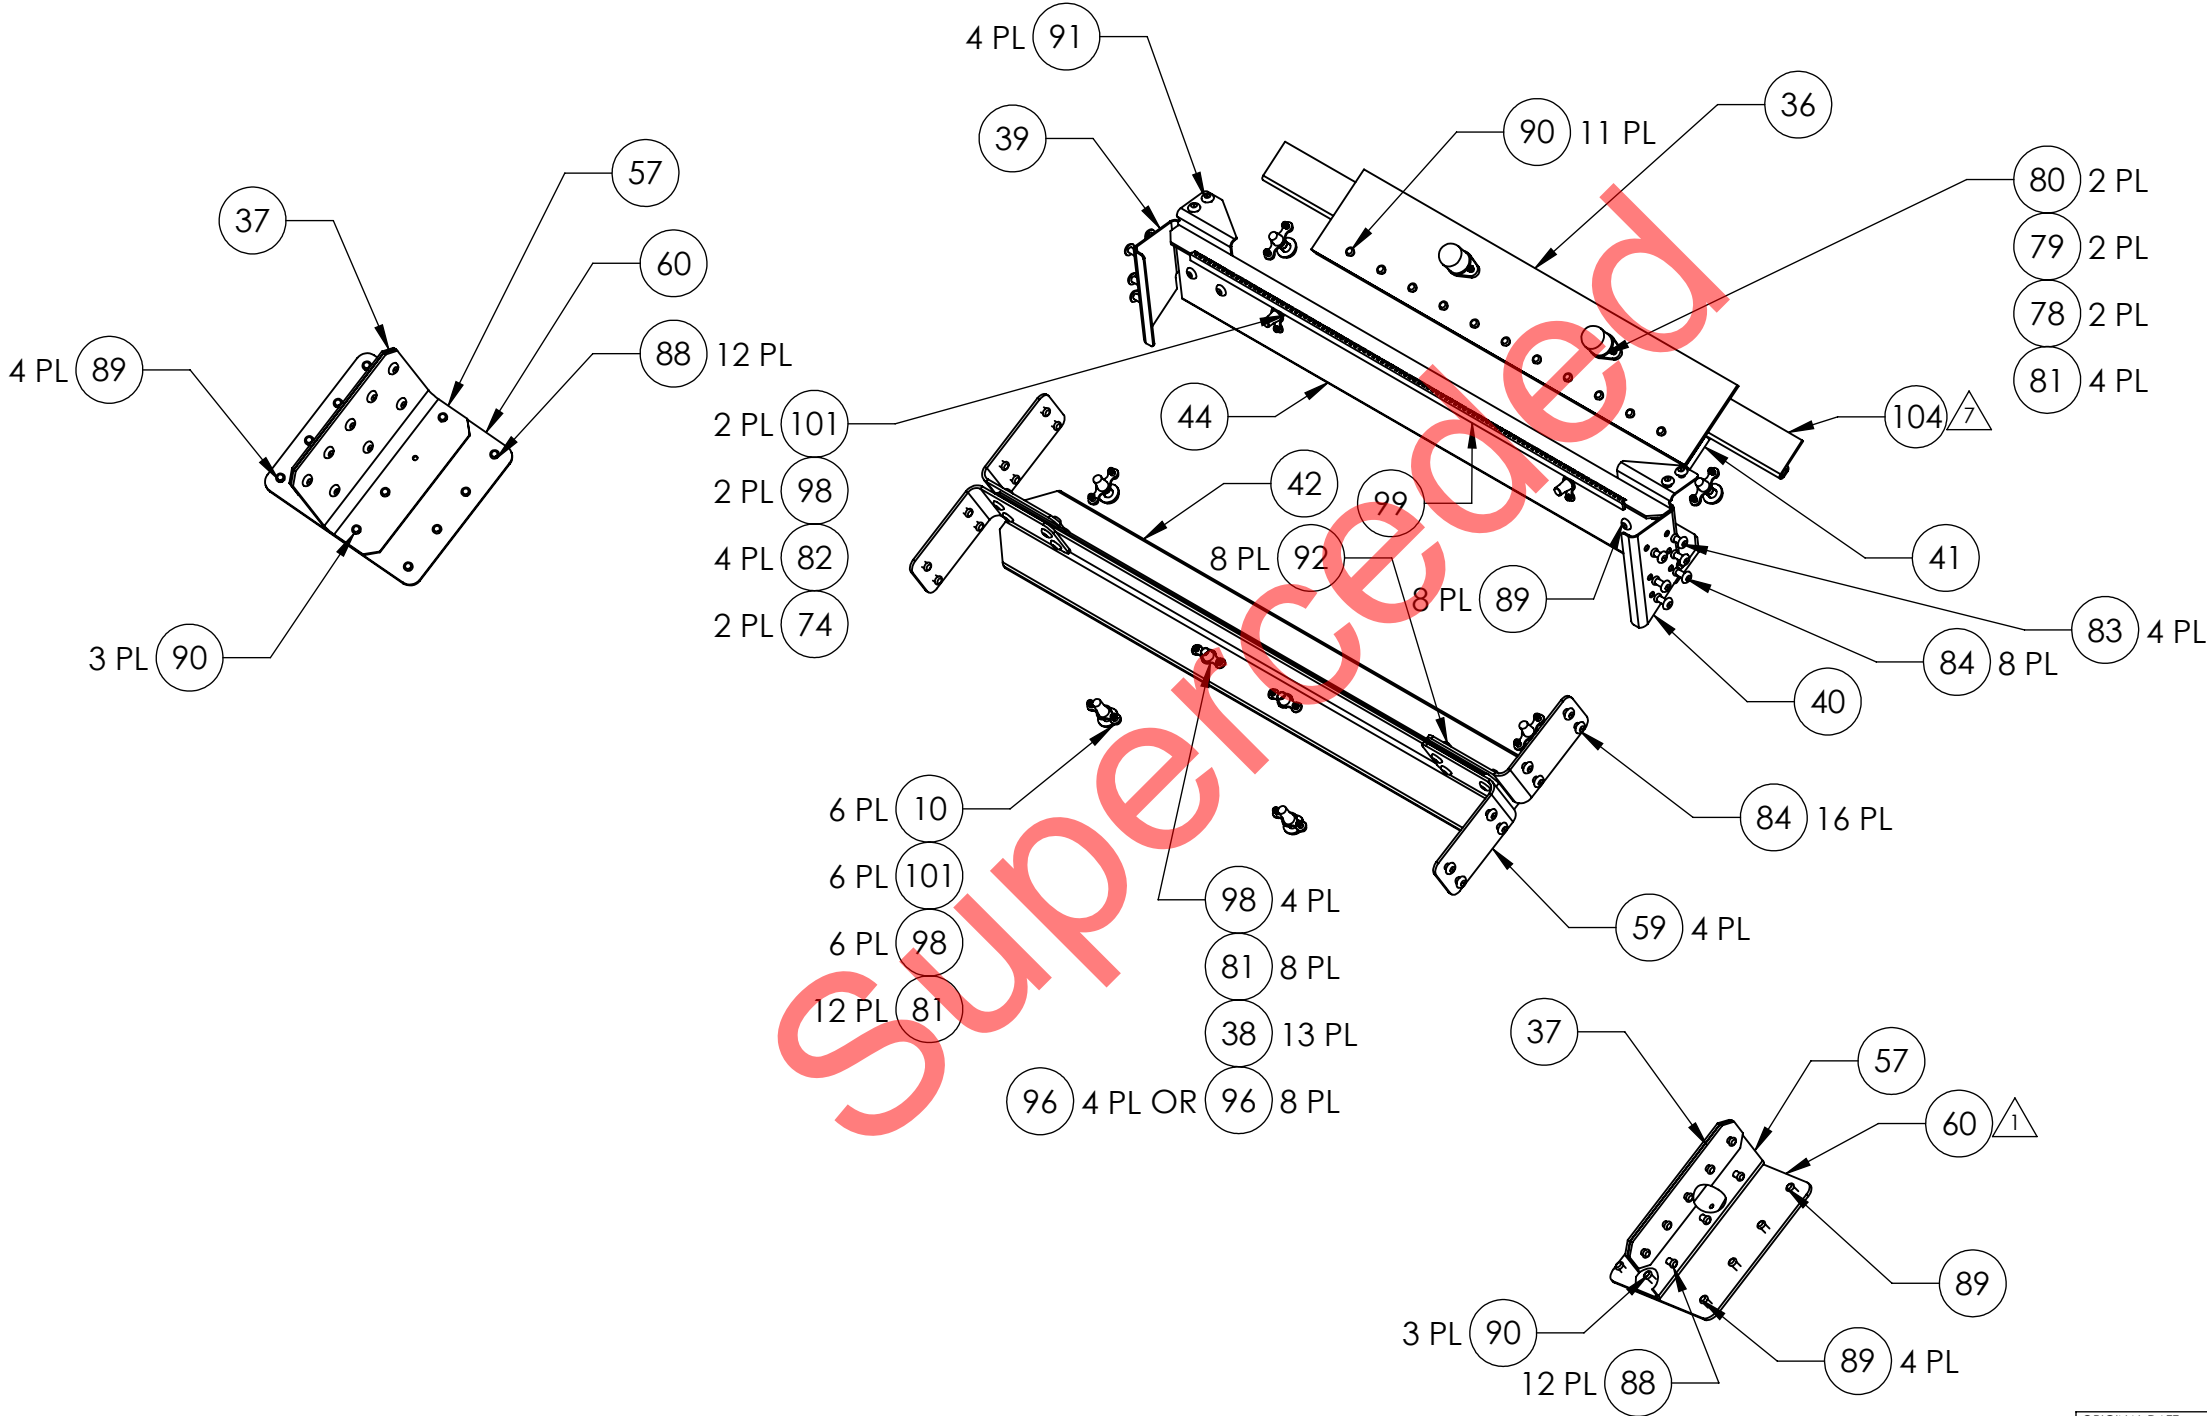


647.7332 UNIVERSAL LOWER CUTTER FIXED PROVISIONS

UNDER REVIEW
ECR: #16 20.08.05 (JB)

ORIGINAL DATE (MO-DA-YR) 11/24/09		DART 3030 ENTERPRISE CT., SUITE A VISTA, CA. 92081 (760)-724-5300	
DRAWN BY A. QUAN	CHECKER D. BARKER		
DRAWING APPROVAL P. BRAVO 01/13/10		APICAL INDUSTRIES, INC. dba DART AEROSPACE	
CONTRACT No.		EC135 CABLE CUTTERS KIT	
UNLESS OTHERWISE SPECIFIED DIMENSIONS ARE IN INCHES TOLERANCES ARE: 2 PLACE DECIMALS ±.01 3 PLACE DECIMALS ±.005 ANGLES ± .5°		SIZE B	REV. F
CAGE CODE 07MZ6		DWG. NO. 647.7300	SHEET 12 OF 25
SCALE NONE			

THE INFORMATION CONTAINED IN THIS DRAWING IS THE SOLE PROPERTY OF APICAL INDUSTRIES DBA DART AEROSPACE. ANY REPRODUCTION IN PART OR WHOLE WITHOUT THE WRITTEN PERMISSION OF APICAL INDUSTRIES DBA DART AEROSPACE IS PROHIBITED.

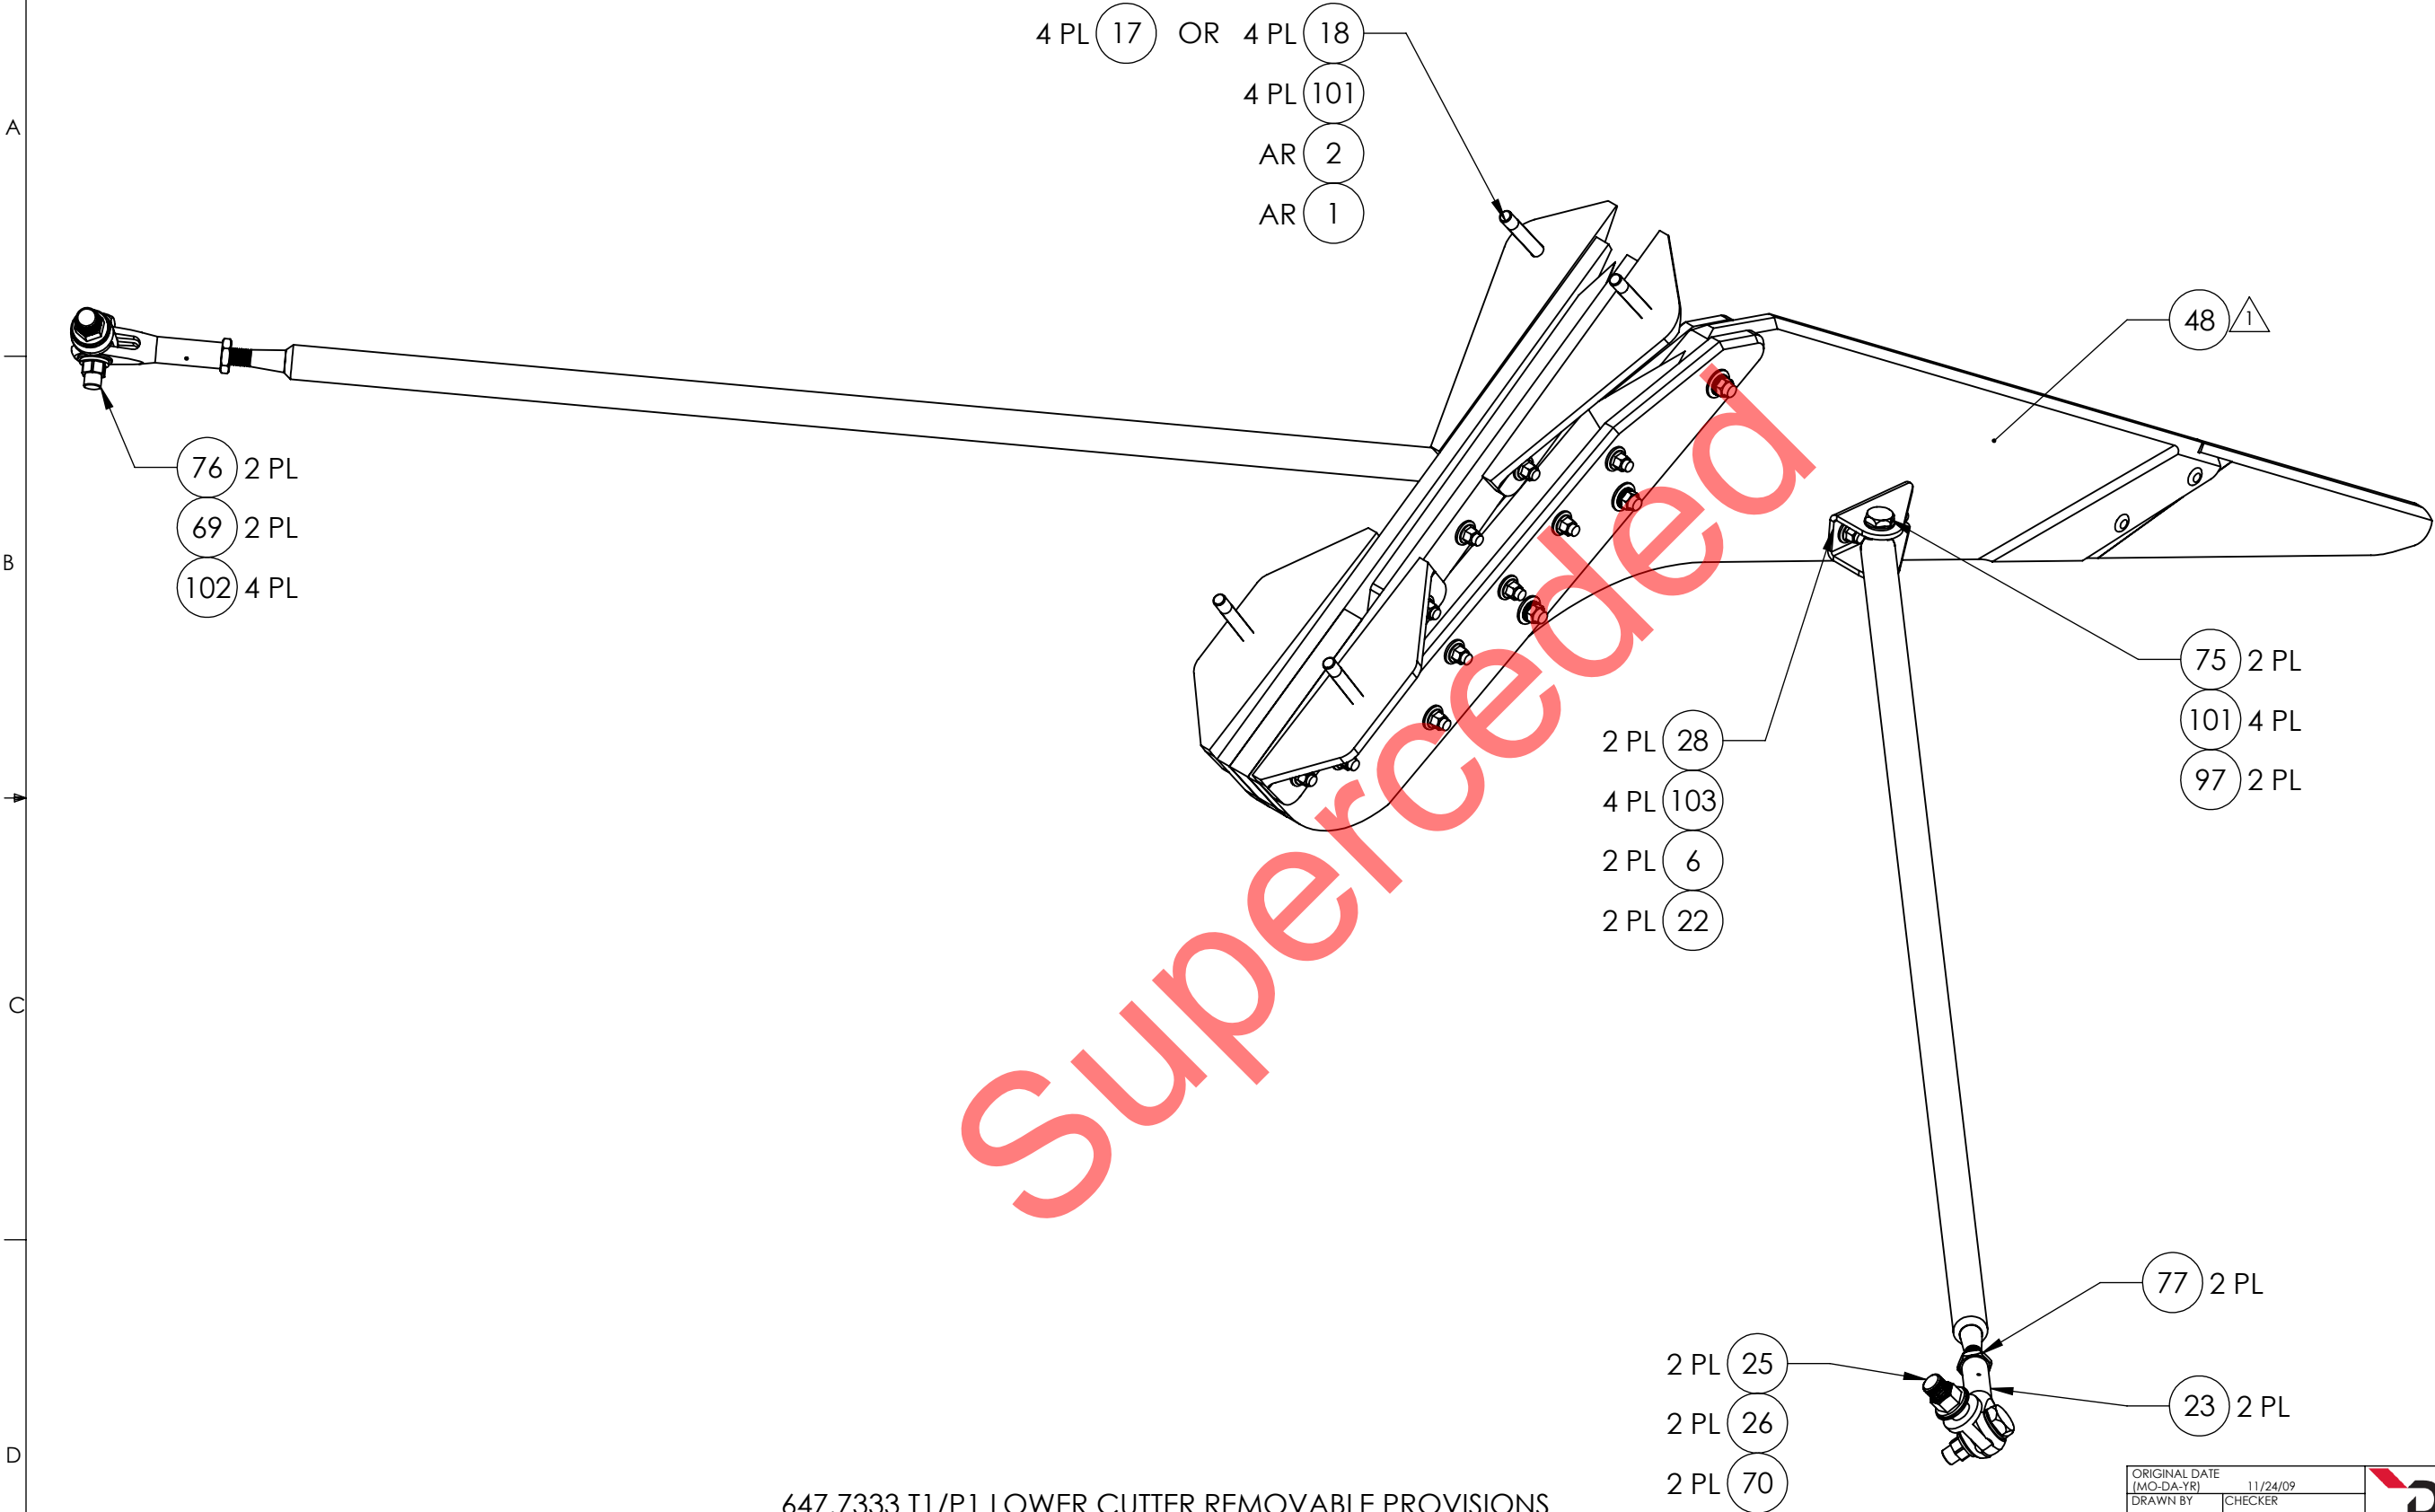

647.7333 T1/P1 LOWER CUTTER REMOVABLE PROVISIONS

ORIGINAL DATE (MO-DA-YR)	11/24/09
DRAWN BY A. QUAN	CHECKER D. BARKER
DRAWING APPROVAL P. BRAVO 01/13/10	
CONTRACT No.	



3030 ENTERPRISE CT.,
SUITE A
VISTA, CA. 92081
(760)-724-5300

APICAL INDUSTRIES, INC.
dba DART AEROSPACE


EC135 CABLE CUTTERS KIT

UNLESS OTHERWISE SPECIFIED
DIMENSIONS ARE IN INCHES
TOLERANCES ARE:
2 PLACE DECIMALS ±.01
3 PLACE DECIMALS ±.005
ANGLES ±.5°

SIZE	CAGE CODE	DWG. NO.	REV.
B	07MZ6	647.7300	F
SCALE NONE		SHEET	13 OF 25


UNDER REVIEW
ECR: #16 20.08.05 (JB)

THE INFORMATION CONTAINED IN THIS DRAWING IS THE SOLE PROPERTY OF APICAL INDUSTRIES DBA DART AEROSPACE. ANY REPRODUCTION IN PART OR WHOLE WITHOUT THE WRITTEN PERMISSION OF APICAL INDUSTRIES DBA DART AEROSPACE IS PROHIBITED.


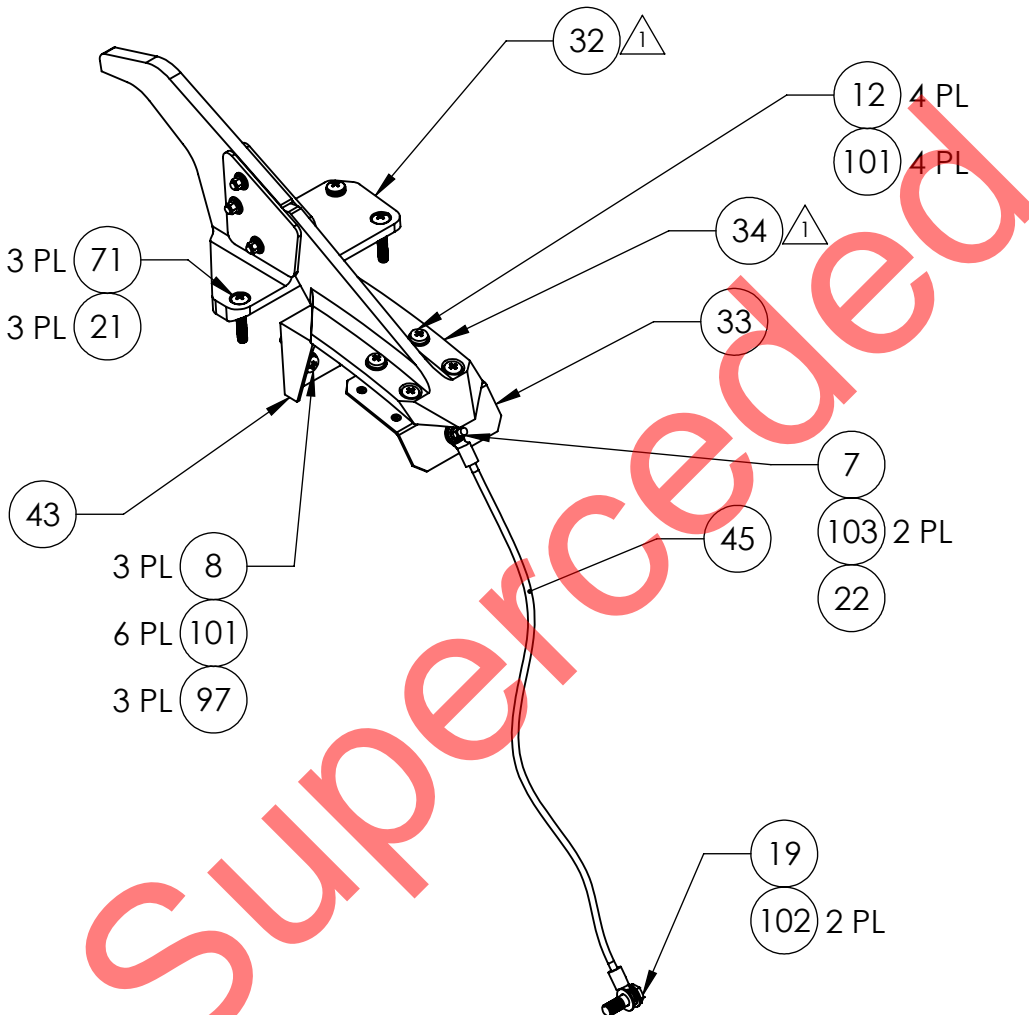


647.7341 UNIVERSAL WIPER DEFLECTOR ASSEMBLY

UNDER REVIEW
ECR: #16 20.08.05 (JB)

ORIGINAL DATE (MO-DA-YR) 11/24/09		 <div>3030 ENTERPRISE CT., SUITE A VISTA, CA. 92081 (760)-724-5300</div>	
DRAWN BY A. QUAN	CHECKER D. BARKER		
DRAWING APPROVAL P. BRAVO 01/13/10			
CONTRACT NO.		EC135 CABLE CUTTERS KIT	
UNLESS OTHERWISE SPECIFIED DIMENSIONS ARE IN INCHES TOLERANCES ARE: 2 PLACE DECIMALS ±.01 3 PLACE DECIMALS ±.005 ANGLES ± .5°		SIZE	REV.
		CAGE CODE 07MZ6	F
		DWG. NO. 647.7300	
		SCALE NONE	SHEET 14 OF 25

THE INFORMATION CONTAINED IN THIS DRAWING IS THE SOLE PROPERTY OF APICAL INDUSTRIES DBA DART AEROSPACE. ANY REPRODUCTION IN PART OR WHOLE WITHOUT THE WRITTEN PERMISSION OF APICAL INDUSTRIES DBA DART AEROSPACE IS PROHIBITED.

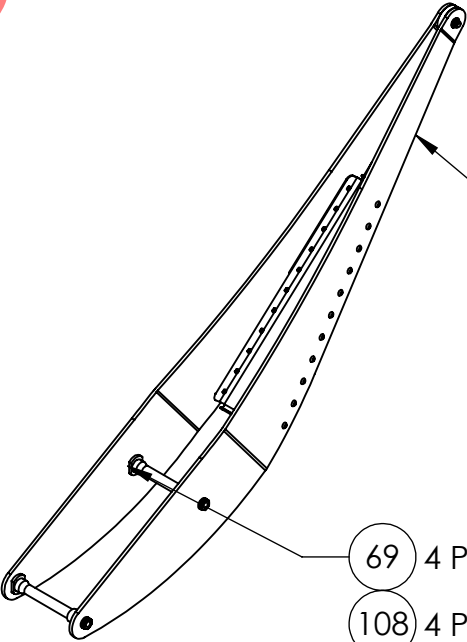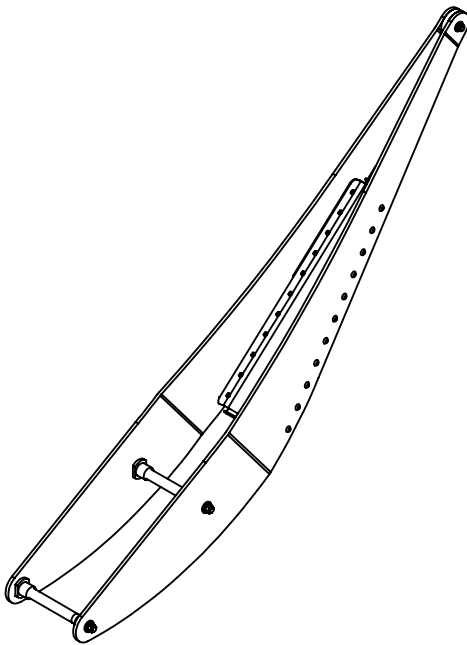

107 2 PL
1

69 4 PL
108 4 PL
109 4 PL
110 8 PL
111 4 PL

647.7351 T1/P1 SKID DEFLECTOR ASSEMBLY

ORIGINAL DATE (MO-DA-YR)	11/24/09
DRAWN BY A. QUAN	CHECKER D. BARKER
DRAWING APPROVAL P. BRAVO 01/13/10	
CONTRACT No.	

**DART**
AEROSPACE
APICAL INDUSTRIES, INC.
dba DART AEROSPACE

3030 ENTERPRISE CT.,
SUITE A
VISTA, CA. 92081
(760)-724-5300


EC135 CABLE CUTTERS KIT

UNLESS OTHERWISE SPECIFIED DIMENSIONS ARE IN INCHES TOLERANCES ARE: 2 PLACE DECIMALS ±.01 3 PLACE DECIMALS ±.005 ANGLES ± .5°
--

SIZE B	CAGE CODE 07MZ6	DWG. NO. 647.7300	REV. F
SCALE NONE	SHEET 15 OF 25		

UNDER REVIEW
ECR: #16 20.08.05 (JB)

THE INFORMATION CONTAINED IN THIS DRAWING IS THE SOLE PROPERTY OF APICAL INDUSTRIES DBA DART AEROSPACE. ANY REPRODUCTION IN PART OR WHOLE WITHOUT THE WRITTEN PERMISSION OF APICAL INDUSTRIES DBA DART AEROSPACE IS PROHIBITED.

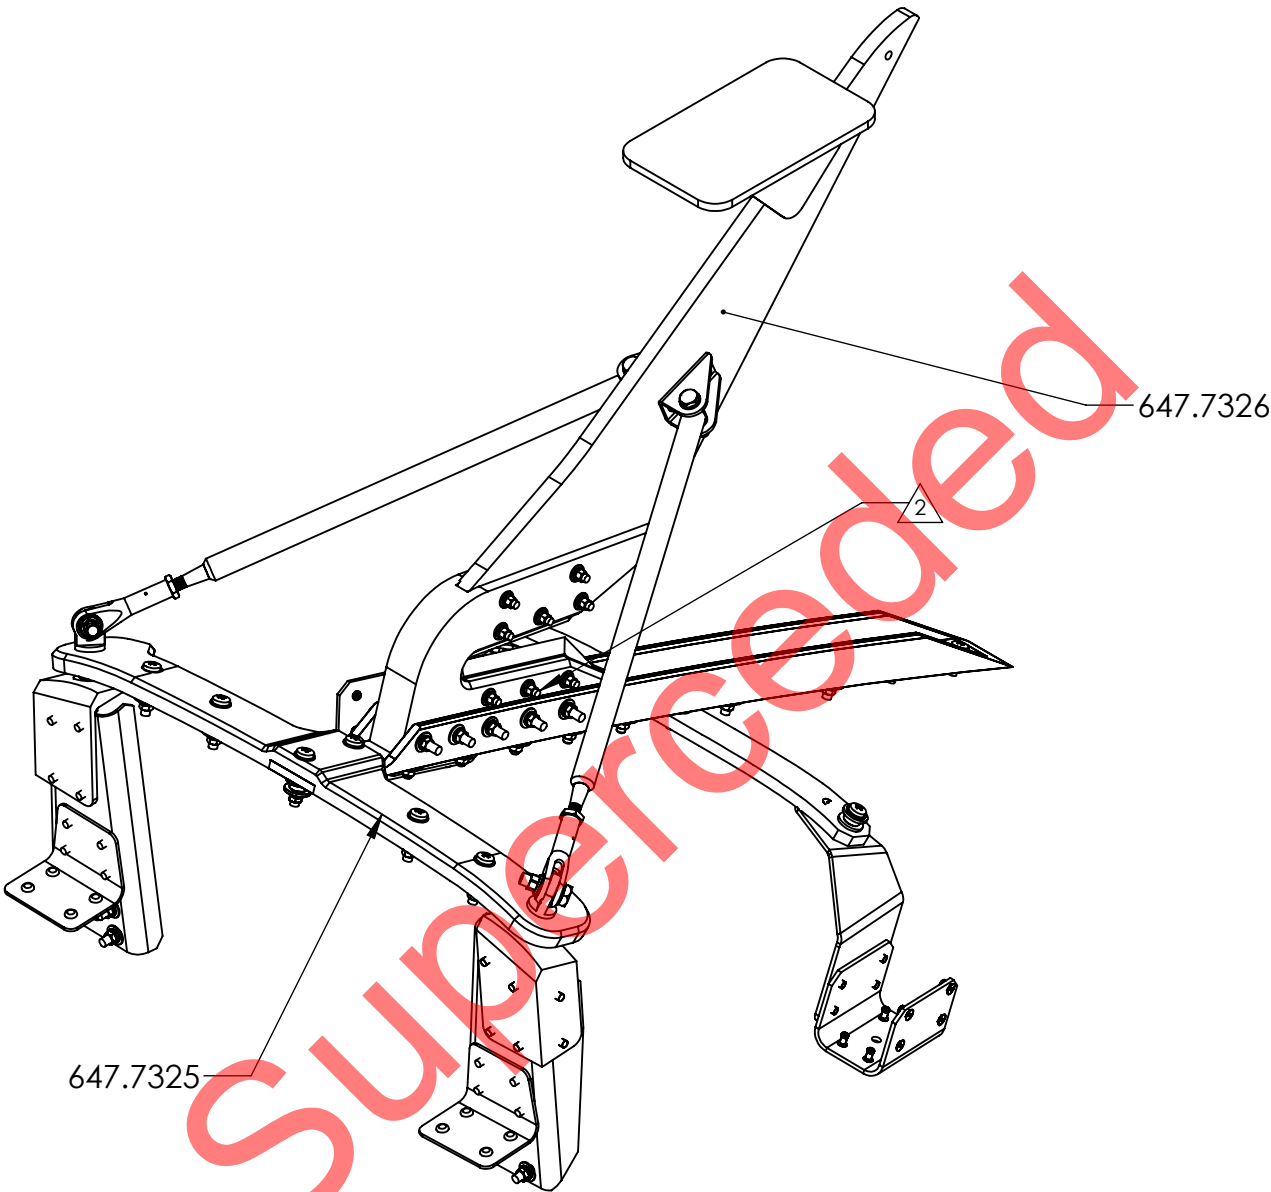

647.7324 T2/P2 UPPER CUTTER ASSEMBLY

ORIGINAL DATE (MO-DA-YR) 11/24/09		<div><div><div>DART</div><div>AEROSPACE</div></div><div>3030 ENTERPRISE CT., SUITE A VISTA, CA. 92081 (760)-724-5300</div></div>	
DRAWN BY A. QUAN	CHECKER D. BARKER		
DRAWING APPROVAL P. BRAVO 01/13/10		APICAL INDUSTRIES, INC. dba DART AEROSPACE	
CONTRACT No.		EC135 CABLE CUTTERS KIT	
UNLESS OTHERWISE SPECIFIED DIMENSIONS ARE IN INCHES TOLERANCES ARE: 2 PLACE DECIMALS ±.01 3 PLACE DECIMALS ±.005 ANGLES ± .5°		SIZE B	REV. F
		CAGE CODE 07MZ6	DWG. NO. 647.7300
		SCALE NONE	SHEET 16 OF 25

UNDER REVIEW
ECR: #16 20.08.05 (JB)

2 PL (68)

AR (2)

AR (1)

54

 $2 \text{ PL} \left(\frac{1}{2} \right)$

64

4 PL (101)
2 PL (97)
2 PL (67)
2 PL (16)

101 8 PL
97 4 PL
67 4 PL
14 4 PL
2 AR
1 AR

8 PL 101
8 PL 95

20 PL	101
10 PL	97
10 PL	9

61

101 4 PL
 97 2 PL
 67 2 PL
 15 2 PL
 2 AR
 1 AR

101 5 PL
 97 5 PL
 67 5 PL
 100 5 PL
 2 AR
 1 AR
 3

55

94 12 PL

93 16 PL

65

6

8 PL (85)

ORIGINAL DATE (MO-DA-YR)		11/24/09
DRAWN BY A. QUAN	CHECKER D. BARKER	
DRAWING APPROVAL P. BRAVO 01/13/10		
CONTRACT No.		

UNLESS OTHERWISE SPECIFIED
DIMENSIONS ARE IN INCHES
TOLERANCES ARE:
2 PLACE DECIMALS $\pm .01$
3 PLACE DECIMALS $\pm .005$
ANGLES $\pm .5^\circ$

101 2 PL

97

67

13

2 AR

1 AR

3

101 4 PL
 97 2 PL
 67 2 PL
 11 2 PL
 2 AR
 1 AR
 3

87 8X

—(58) 2 PL

DART
AEROSPACE
APICAL INDUSTRIES, INC.
dba DART AEROSPACE


3030 ENTERPRISE CT.,
SUITE A
VISTA, CA. 92081
(760)-724-5300

EC135 CABLE CUTTERS KIT

SIZE B	CAGE CODE 07MZ6	DWG. NO. 647.7300	REV. F
SCALE NONE		SHEET 17 OF 25	


~~UNDER REVIEW~~
ECR: #16 20.08.05 (JB)

THE INFORMATION CONTAINED IN THIS DRAWING IS THE SOLE PROPERTY OF APICAL INDUSTRIES DBA DART AEROSPACE. ANY REPRODUCTION IN PART OR WHOLE WITHOUT THE WRITTEN PERMISSION OF APICAL INDUSTRIES DBA DART AEROSPACE IS PROHIBITED.

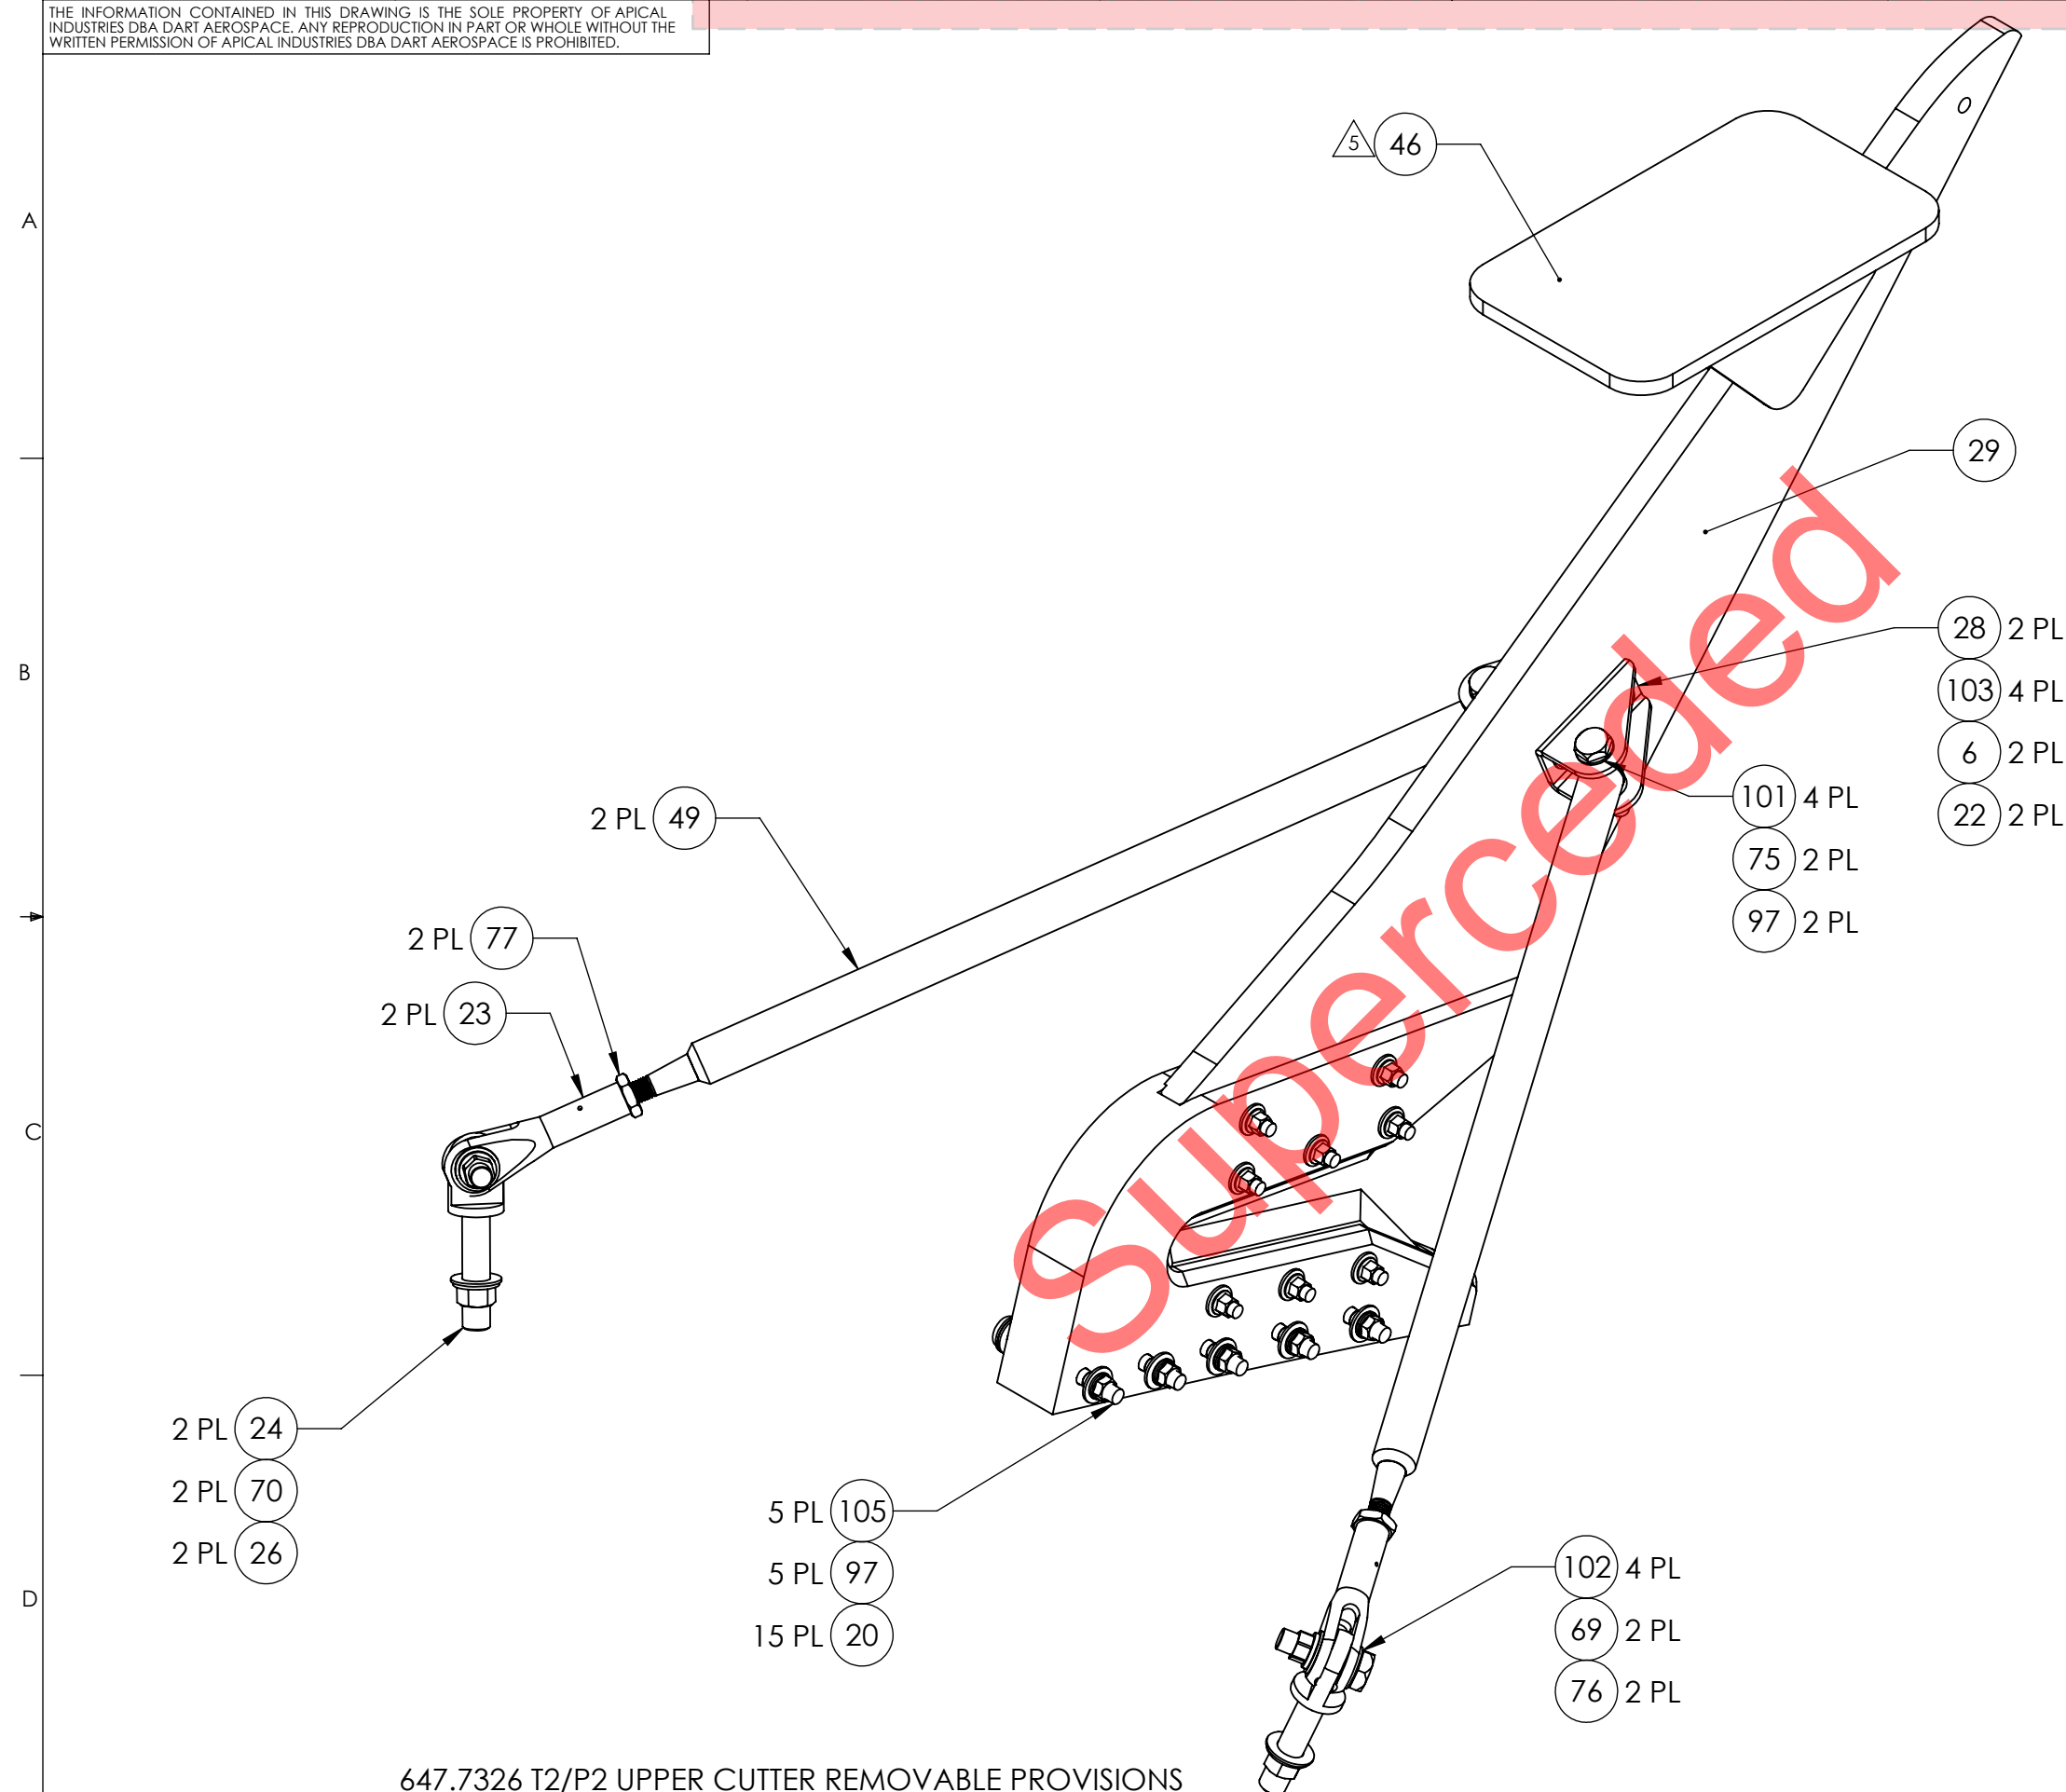


647.7326 T2/P2 UPPER CUTTER REMOVABLE PROVISIONS


UNDER REVIEW
ECR: #16 20.08.05 (JB)

ORIGINAL DATE (MO-DA-YR)		11/24/09		 DART AEROSPACE APICAL INDUSTRIES, INC. dba DART AEROSPACE	3030 ENTERPRISE CT., SUITE A VISTA, CA. 92081 (760)-724-5300		
DRAWN BY A. QUAN		CHECKER D. BARKER					
DRAWING APPROVAL P. BRAVO 01/13/10							
CONTRACT NO.				EC135 CABLE CUTTERS KIT			
UNLESS OTHERWISE SPECIFIED DIMENSIONS ARE IN INCHES TOLERANCES ARE: 2 PLACE DECIMALS ±.01 3 PLACE DECIMALS ±.005 ANGLES ± .5°				SIZE	CAGE CODE	DWG. NO.	REV.
				B	07MZ6	647.7300	F
				SCALE NONE		SHEET	18 OF 25

THE INFORMATION CONTAINED IN THIS DRAWING IS THE SOLE PROPERTY OF APICAL INDUSTRIES DBA DART AEROSPACE. ANY REPRODUCTION IN PART OR WHOLE WITHOUT THE WRITTEN PERMISSION OF APICAL INDUSTRIES DBA DART AEROSPACE IS PROHIBITED.

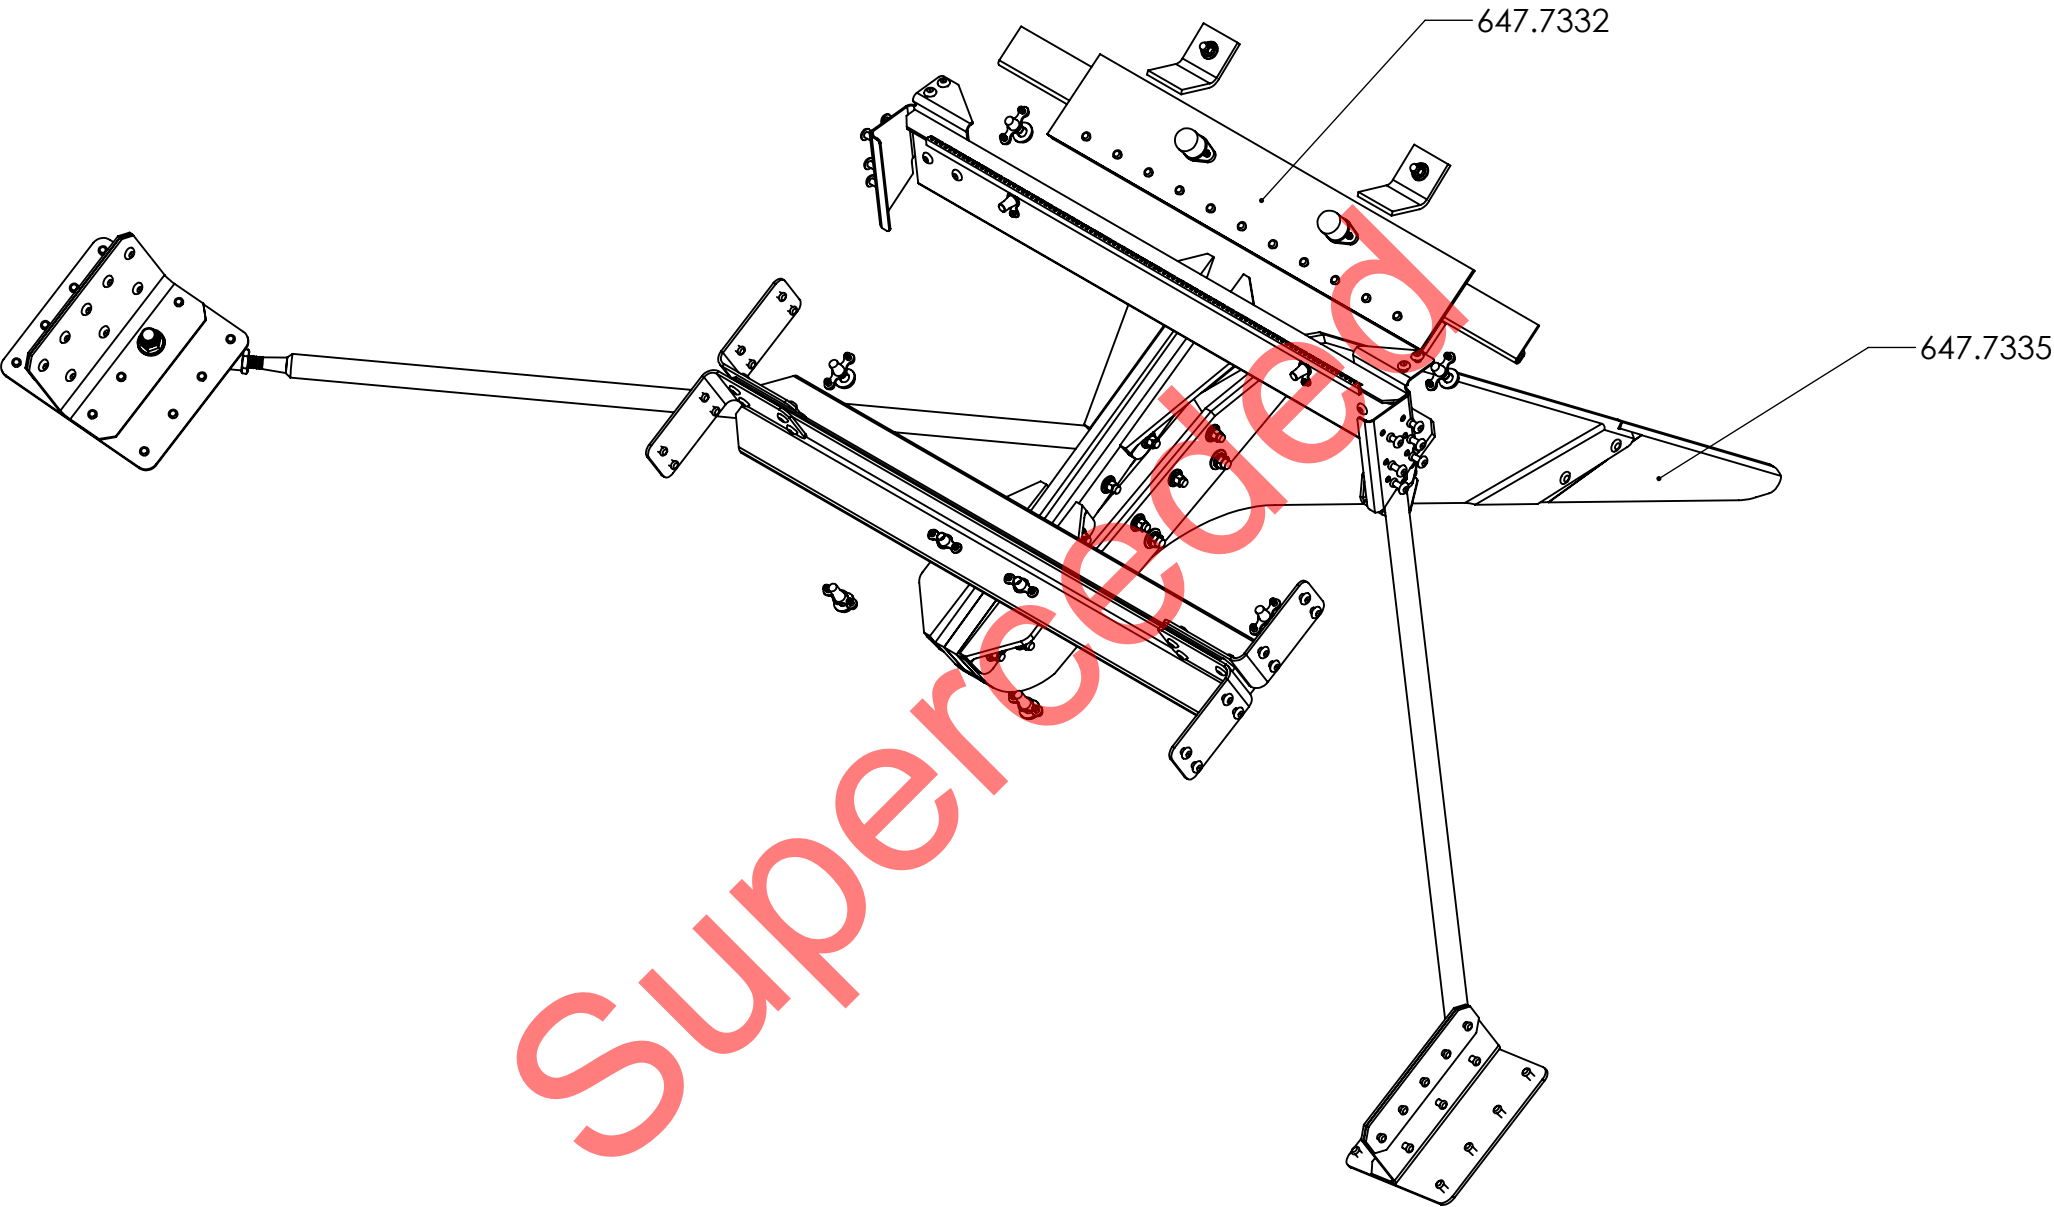


647.7334 T2/P2/T3/P3/T3H/P3H LOWER CUTTER ASSEMBLY


ORIGINAL DATE (MO-DA-YR) 11/24/09		 3030 ENTERPRISE CT., SUITE A VISTA, CA. 92081 (760)-724-5300	
DRAWN BY A. QUAN	CHECKER D. BARKER		
DRAWING APPROVAL P. BRAVO 01/13/10			
CONTRACT No.		EC135 CABLE CUTTERS KIT	
UNLESS OTHERWISE SPECIFIED DIMENSIONS ARE IN INCHES TOLERANCES ARE: 2 PLACE DECIMALS ±.01 3 PLACE DECIMALS ±.005 ANGLES ± .5°		SIZE	REV.
		CAGE CODE 07MZ6	F
		DWG. NO. 647.7300	
		SCALE NONE	SHEET 19 OF 25

UNDER REVIEW
ECR: #16 20.08.05 (JB)

THE INFORMATION CONTAINED IN THIS DRAWING IS THE SOLE PROPERTY OF APICAL INDUSTRIES DBA DART AEROSPACE. ANY REPRODUCTION IN PART OR WHOLE WITHOUT THE WRITTEN PERMISSION OF APICAL INDUSTRIES DBA DART AEROSPACE IS PROHIBITED.

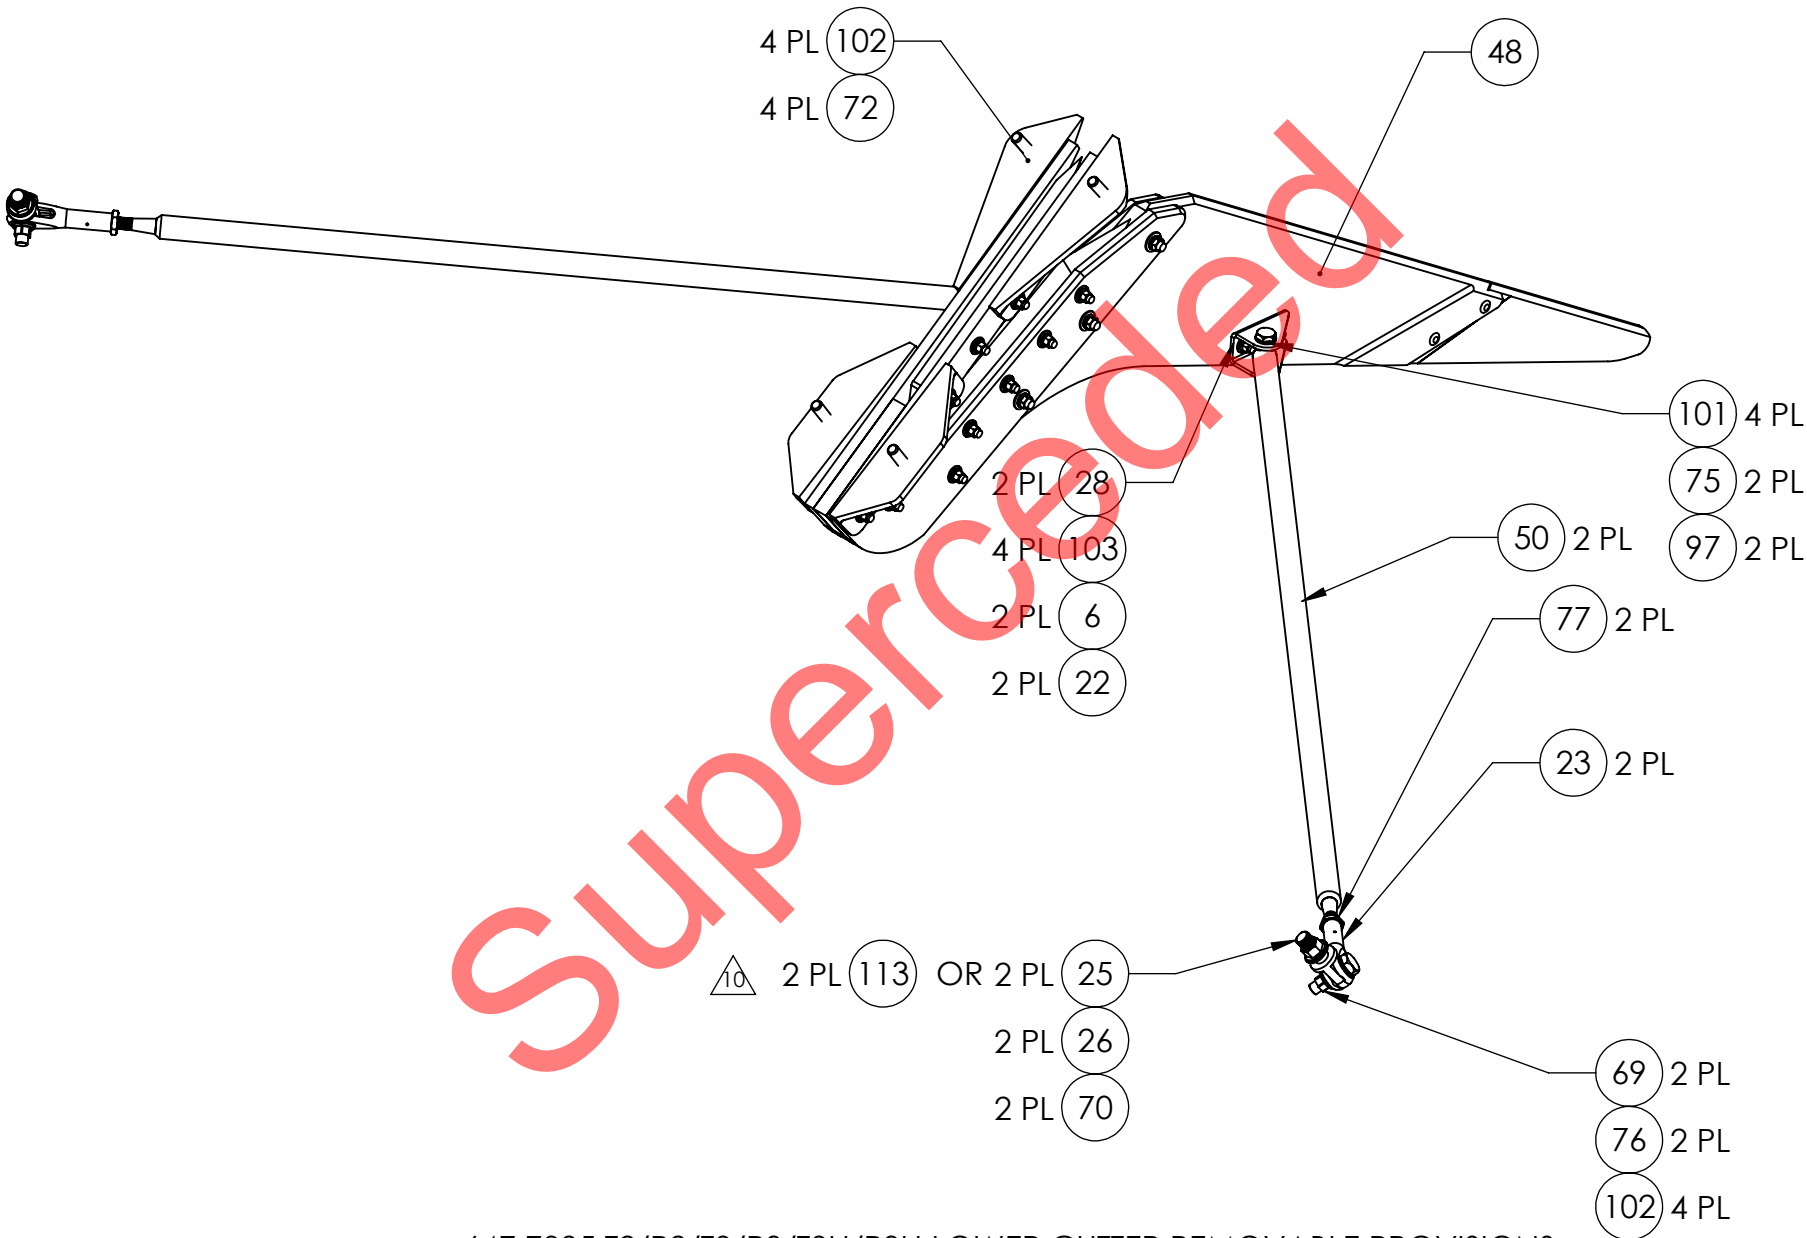

647.7335 T2/P2/T3/P3/T3H/P3H LOWER CUTTER REMOVABLE PROVISIONS


ORIGINAL DATE (MO-DA-YR) 11/24/09		 3030 ENTERPRISE CT., SUITE A VISTA, CA. 92081 (760)-724-5300			
DRAWN BY A. QUAN	CHECKER D. BARKER				
DRAWING APPROVAL P. BRAVO 01/13/10					
CONTRACT No.		EC135 CABLE CUTTERS KIT			
UNLESS OTHERWISE SPECIFIED DIMENSIONS ARE IN INCHES TOLERANCES ARE: 2 PLACE DECIMALS ±.01 3 PLACE DECIMALS ±.005 ANGLES ± .5°		SIZE	CAGE CODE	DWG. NO.	REV.
		B	07M26	647.7300	F
		SCALE NONE		SHEET	20 OF 25

UNDER REVIEW
ECR: #16 20.08.05 (JB)

THE INFORMATION CONTAINED IN THIS DRAWING IS THE SOLE PROPERTY OF APICAL INDUSTRIES DBA DART AEROSPACE. ANY REPRODUCTION IN PART OR WHOLE WITHOUT THE WRITTEN PERMISSION OF APICAL INDUSTRIES DBA DART AEROSPACE IS PROHIBITED.




647.7352 T2/P2/T3/P3/T3H/P3H SKID DEFLECTOR ASSEMBLY


ORIGINAL DATE (MO-DA-YR) 11/24/09		 DART AEROSPACE APICAL INDUSTRIES, INC. dba DART AEROSPACE		3030 ENTERPRISE CT., SUITE A VISTA, CA. 92081 (760)-724-5300	
DRAWN BY A. QUAN	CHECKER D. BARKER				
DRAWING APPROVAL P. BRAVO 01/13/10		EC135 CABLE CUTTERS KIT			
CONTRACT No.					
UNLESS OTHERWISE SPECIFIED DIMENSIONS ARE IN INCHES TOLERANCES ARE: 2 PLACE DECIMALS ±.01 3 PLACE DECIMALS ±.005 ANGLES ±.5°		SIZE	CAGE CODE	DWG. NO.	REV.
		B	07MZ6	647.7300	F
		SCALE NONE		SHEET	21 OF 25

UNDER REVIEW
ECR: #16 20.08.05 (JB)

THE INFORMATION CONTAINED IN THIS DRAWING IS THE SOLE PROPERTY OF APICAL INDUSTRIES DBA DART AEROSPACE. ANY REPRODUCTION IN PART OR WHOLE WITHOUT THE WRITTEN PERMISSION OF APICAL INDUSTRIES DBA DART AEROSPACE IS PROHIBITED.

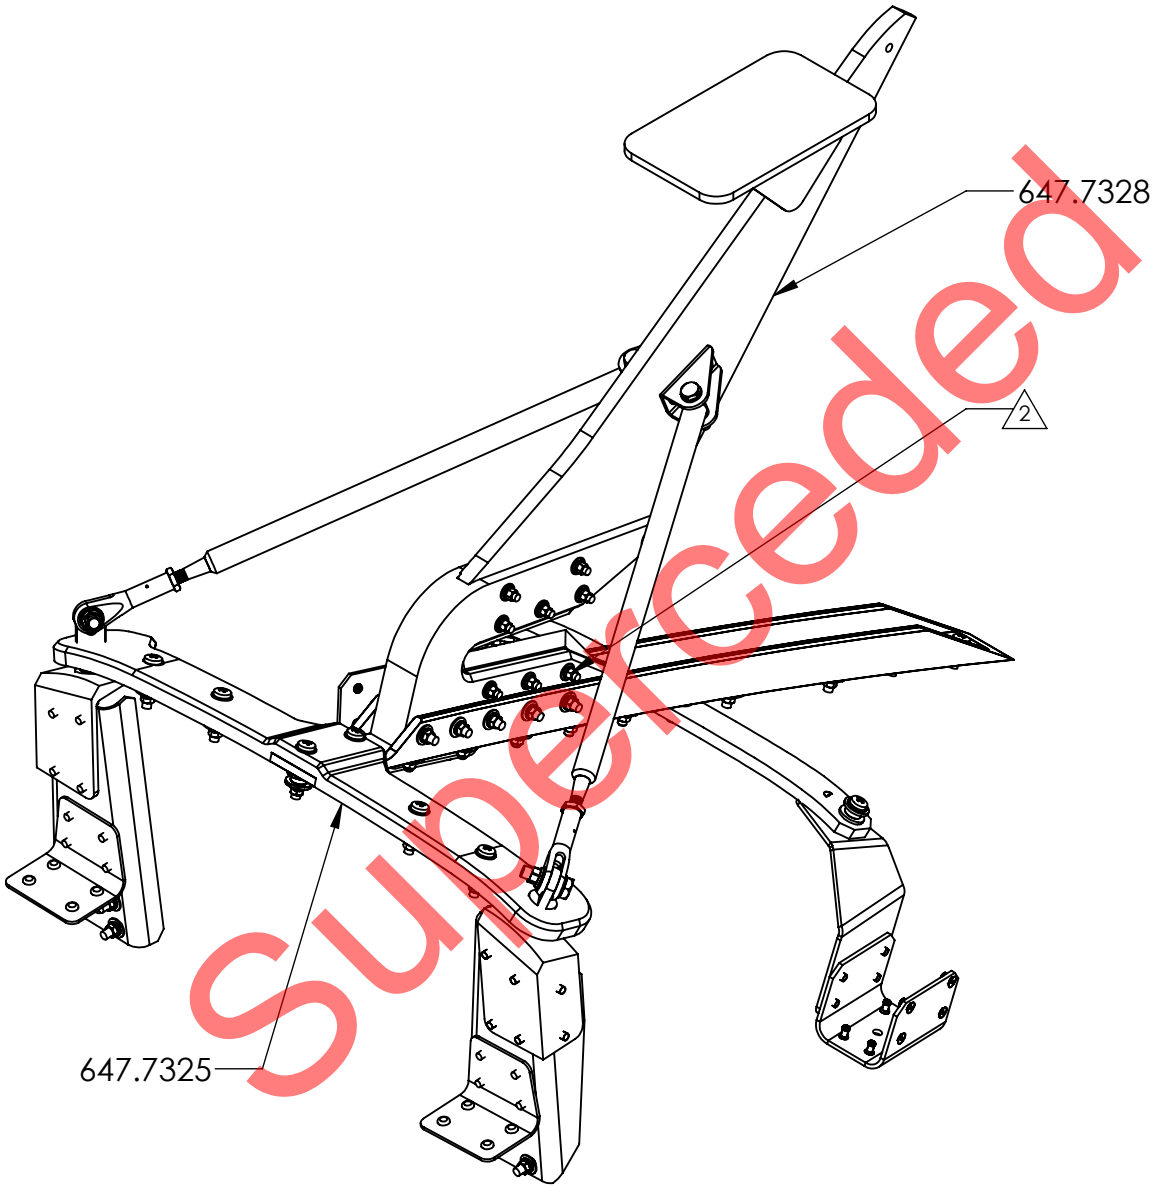


647.7327 T3/P3 UPPER CUTTER ASSEMBLY

ORIGINAL DATE (MO-DA-YR) 11/24/09		 3030 ENTERPRISE CT., SUITE A VISTA, CA. 92081 (760)-724-5300	
DRAWN BY A. QUAN	CHECKER D. BARKER		
DRAWING APPROVAL P. BRAVO 01/13/10		APICAL INDUSTRIES, INC. dba DART AEROSPACE	
CONTRACT No.		EC135 CABLE CUTTERS KIT	
UNLESS OTHERWISE SPECIFIED DIMENSIONS ARE IN INCHES TOLERANCES ARE: 2 PLACE DECIMALS ±.01 3 PLACE DECIMALS ±.005 ANGLES ± .5°		SIZE B 07MZ6	REV. F
		DWG. NO. 647.7300	
		SCALE NONE	SHEET 22 OF 25

UNDER REVIEW
ECR: #16 20.08.05 (JB)


THE INFORMATION CONTAINED IN THIS DRAWING IS THE SOLE PROPERTY OF APICAL INDUSTRIES DBA DART AEROSPACE. ANY REPRODUCTION IN PART OR WHOLE WITHOUT THE WRITTEN PERMISSION OF APICAL INDUSTRIES DBA DART AEROSPACE IS PROHIBITED.

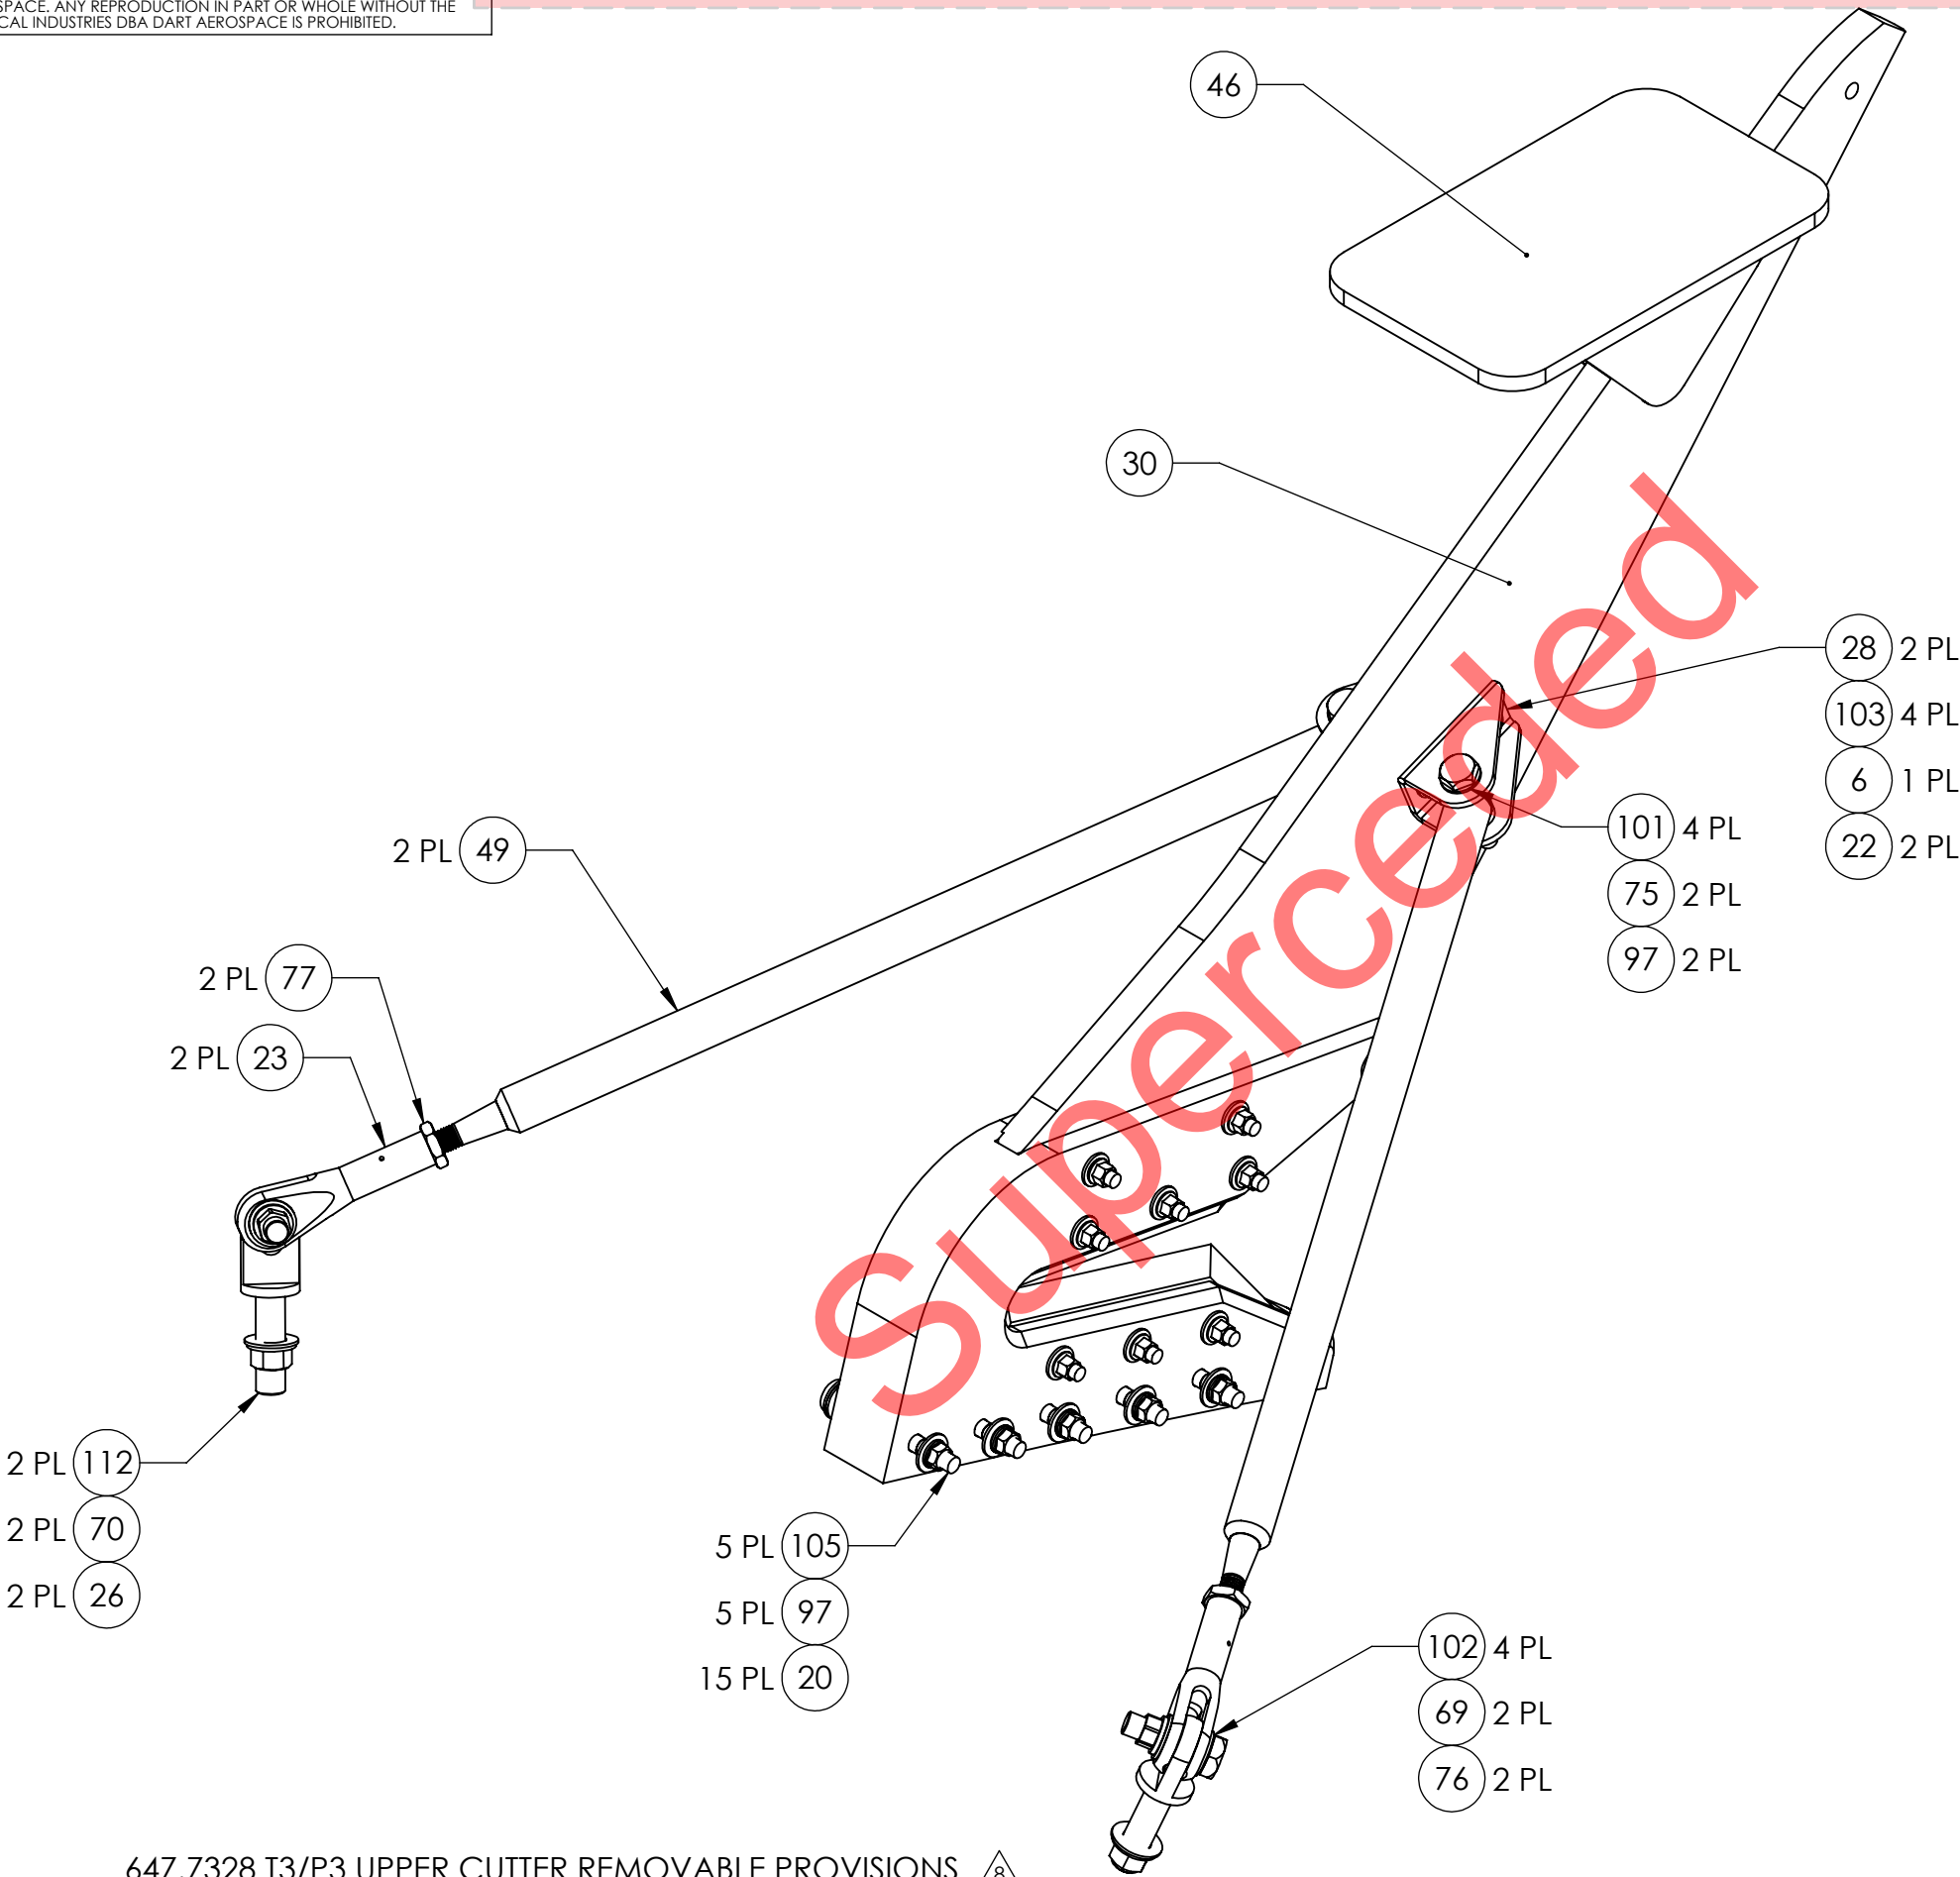


647.7328 T3/P3 UPPER CUTTER REMOVABLE PROVISIONS



UNDER REVIEW
ECR: #16 20.08.05 (JB)

ORIGINAL DATE (MO-DA-YR) 11/24/09		 3030 ENTERPRISE CT., SUITE A VISTA, CA. 92081 (760)-724-5300	
DRAWN BY A. QUAN	CHECKER D. BARKER		
DRAWING APPROVAL P. BRAVO 01/13/10		APICAL INDUSTRIES, INC. dba DART AEROSPACE	
CONTRACT No.		EC135 CABLE CUTTERS KIT	
UNLESS OTHERWISE SPECIFIED DIMENSIONS ARE IN INCHES TOLERANCES ARE: 2 PLACE DECIMALS ±.01 3 PLACE DECIMALS ±.005 ANGLES ± .5°		SIZE B 07MZ6	REV. F
		DWG. NO. 647.7300	SHEET 23 OF 25
SCALE NONE			

THE INFORMATION CONTAINED IN THIS DRAWING IS THE SOLE PROPERTY OF APICAL INDUSTRIES DBA DART AEROSPACE. ANY REPRODUCTION IN PART OR WHOLE WITHOUT THE WRITTEN PERMISSION OF APICAL INDUSTRIES DBA DART AEROSPACE IS PROHIBITED.

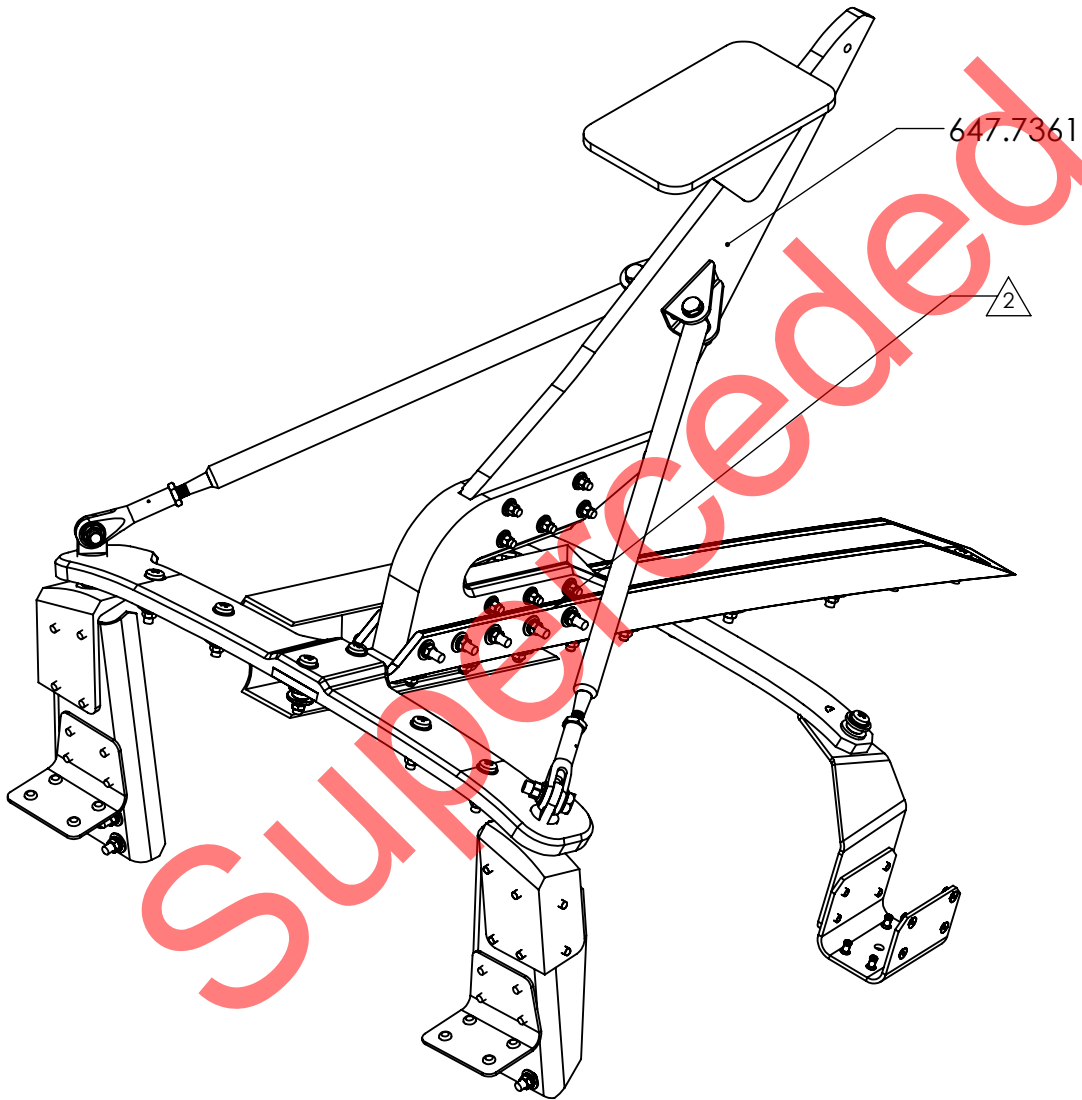

647.7329 T3H/P3H UPPER CUTTER ASSEMBLY

ORIGINAL DATE (MO-DA-YR) 11/24/09		<div><div><div>DART</div><div>AEROSPACE</div></div><div>3030 ENTERPRISE CT., SUITE A VISTA, CA. 92081 (760)-724-5300</div></div>	
DRAWN BY A. QUAN	CHECKER D. BARKER		
DRAWING APPROVAL P. BRAVO 01/13/10		APICAL INDUSTRIES, INC. dba DART AEROSPACE	
CONTRACT No.		EC135 CABLE CUTTERS KIT	
UNLESS OTHERWISE SPECIFIED DIMENSIONS ARE IN INCHES TOLERANCES ARE: 2 PLACE DECIMALS ±.01 3 PLACE DECIMALS ±.005 ANGLES ± .5°		SIZE B 07MZ6	REV. F
		DWG. NO. 647.7300	
		SCALE NONE	SHEET 24 OF 25

UNDER REVIEW
ECR: #16 20.08.05 (JB)

PRINTED COPY OF THIS DOCUMENT IS FOR REFERENCE ONLY AND IS UNCONTROLLED



PRINTED COPY OF THIS DOCUMENT IS FOR REFERENCE ONLY AND IS UNCONTROLLED

PRINTED COPY OF THIS DOCUMENT IS FOR REFERENCE ONLY AND IS UNCONTROLLED

PRINTED COPY OF THIS DOCUMENT IS FOR REFERENCE ONLY AND IS UNCONTROLLED